


T. 35 S. R. 4 W. W.M.

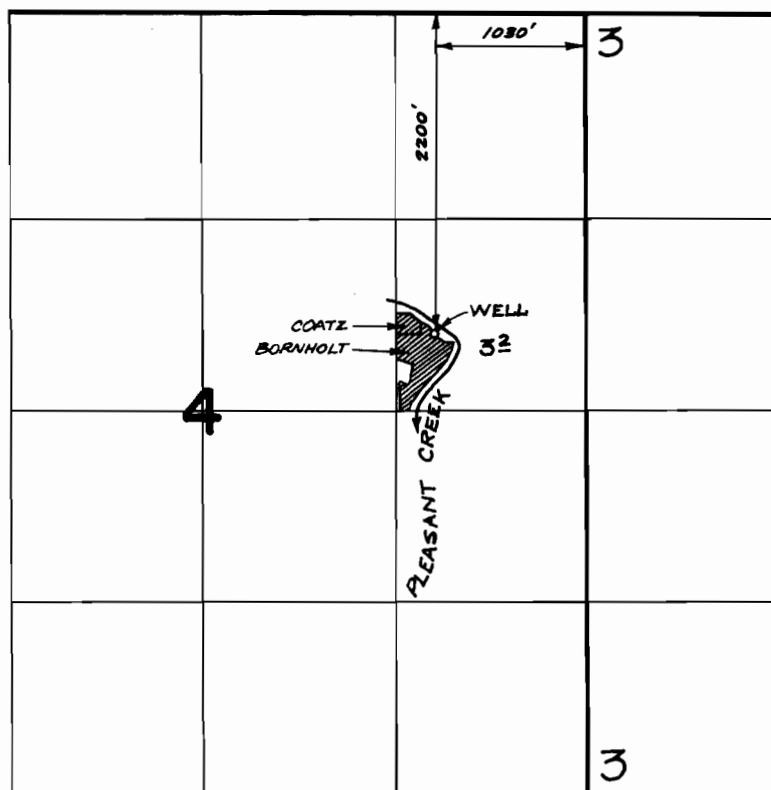

FINAL PROOF SURVEY
UNDER

Application No. G4818 Permit No. G4538
IN NAME OF
MARVIN for JUANITA BORNHOLDT
ELEANDR R. KOETZ

Surveyed JULY 23 1974, by D. NORBY