


# T.32S.R.1E.W.M.

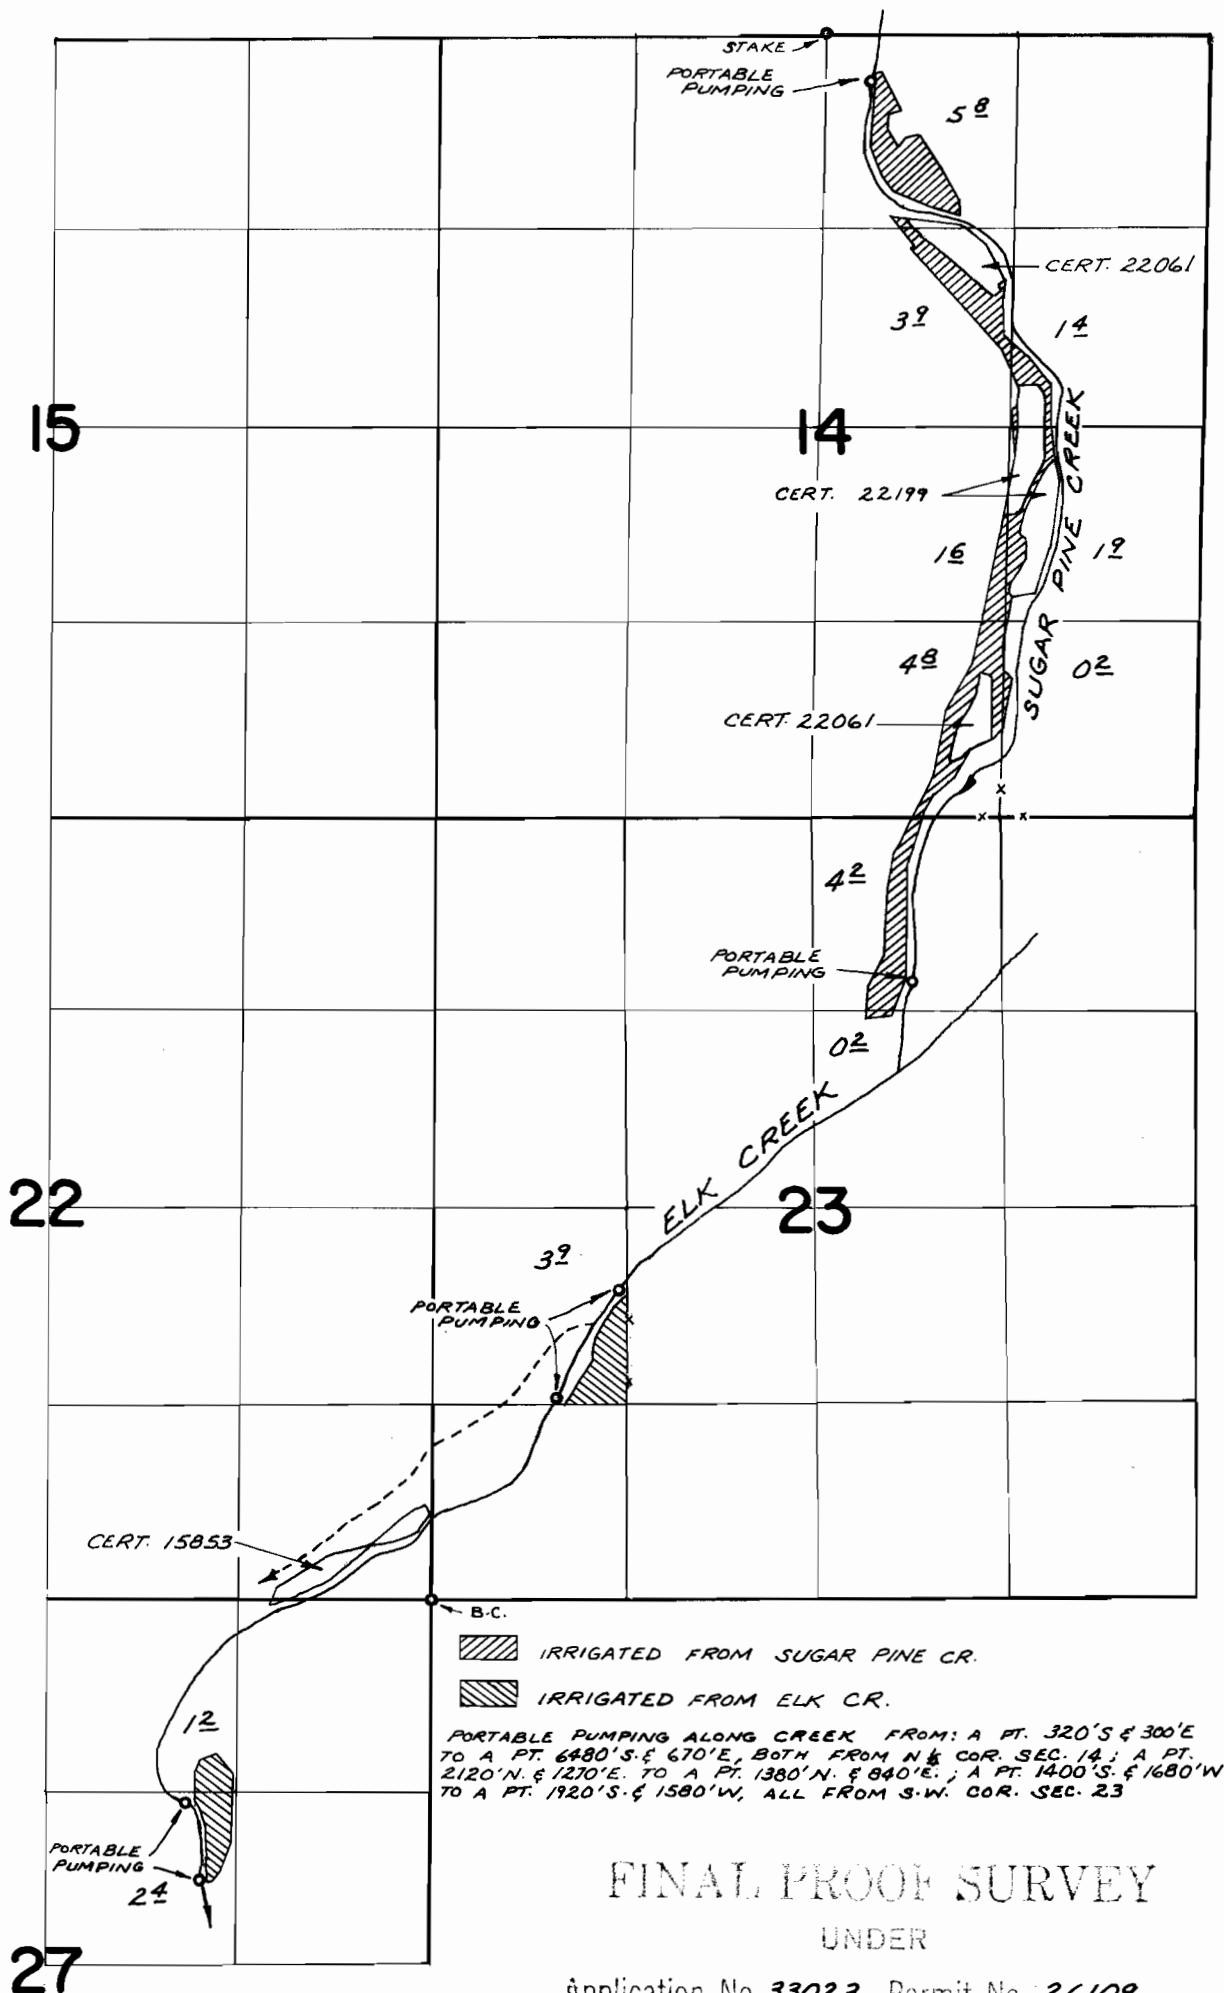

## FINAL PROOF SURVEY

UNDER

Application No. 33023 Permit No. 26109

IN NAME OF

OSCAR & MABEL HANSON

Surveyed JUNE 15 1963, by C. BAKER  
OCT. 21, 1971 R. MUCKEN