


T.36 S. R.6 W. W.M.

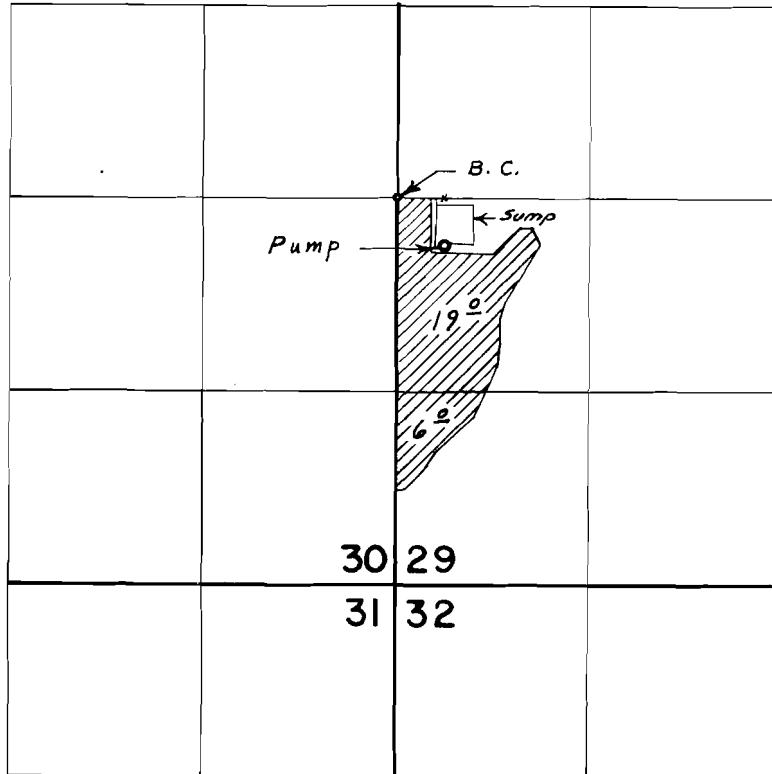

Well located 180' S. & 400' E. from W. $\frac{1}{4}$ Cor. Sec. 29

FINAL PROOF SURVEY
UNDER

Application No. G-5174 Permit No. G-4905
IN NAME OF

MERLYN D. BOROUGH

Surveyed April 25, 1974, by L. E. Gould