


T.37S. R.7W. W.M

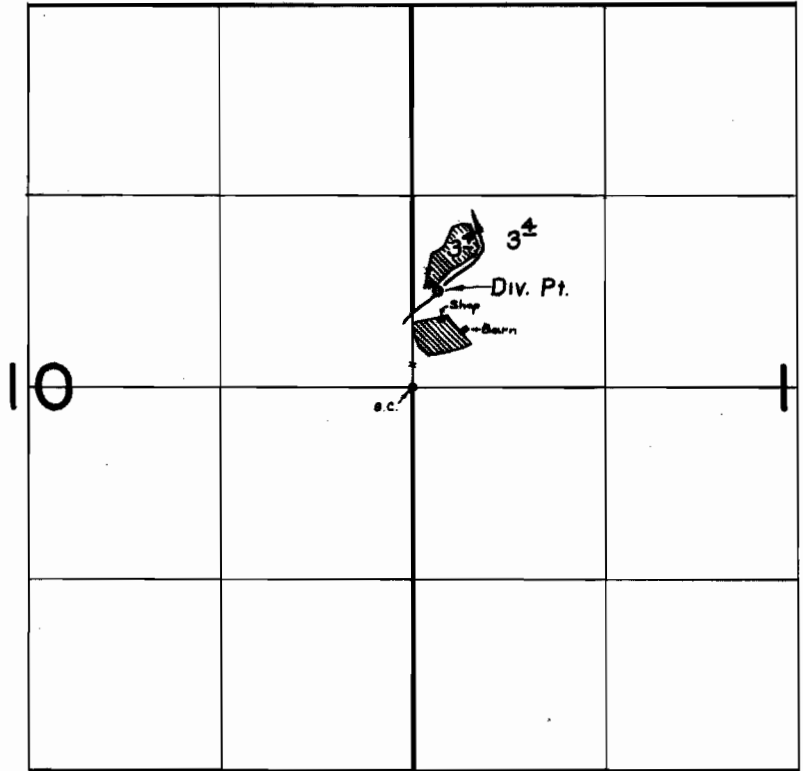

DIV. PT. LOC: 660' N. AND 180' E. FROM W. 1/4 COR. SEC. 11

**FINAL PROOF SURVEY**  
UNDER

Application No. 42604 Transfer B-161  
Permit No. 31829  
IN NAME OF

LEONARD F. BUCHANAN

Surveyed MAY 23, 1974, by L.E. GOULD