


T.I.O.S.R.II W.W.M.

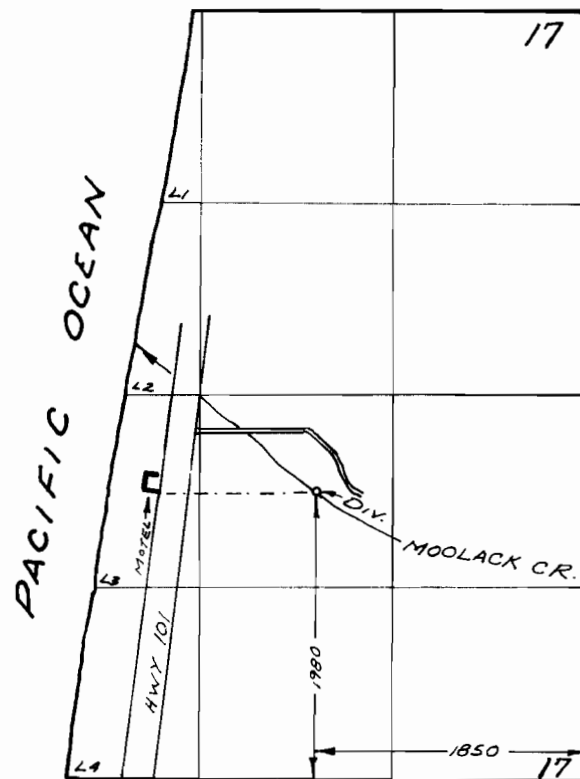

FINAL PROOF SURVEY
UNDER

Application No. 41549 Permit No. 30707
IN NAME OF

Charles & Ilse Jolley

Surveyed SEPT. 21 1973, by R. MUCKEN