


T.I.O.S.R.I.O.W.W.M.

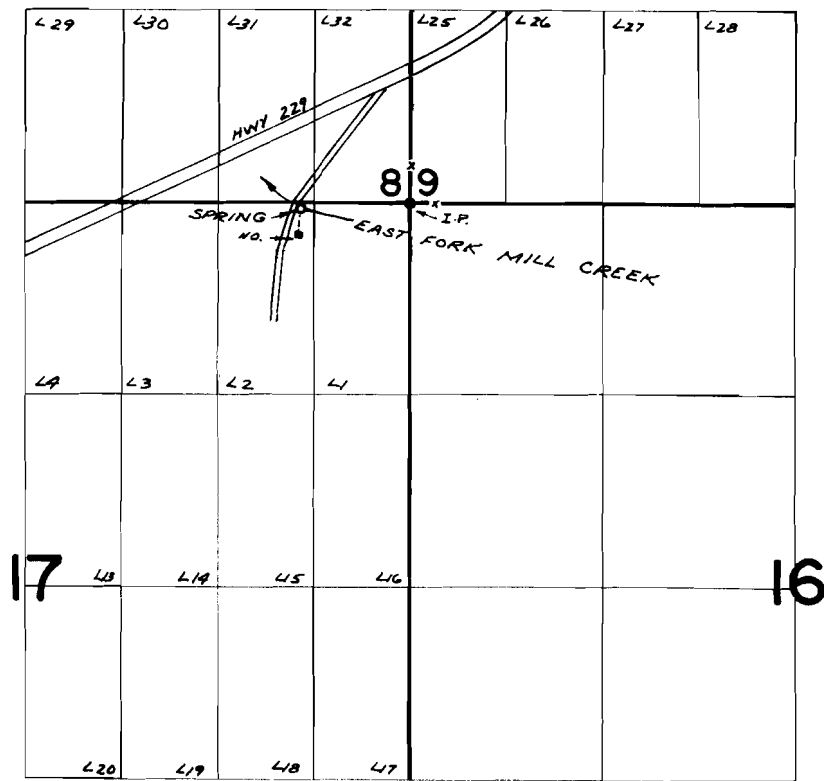

SPRING LOC: 40'S. & 750'W. FROM N.E. COR. SEC. 17

FINAL PROOF SURVEY UNDER

Application No. 46436 Permit No. 34695
IN NAME OF

ALFRED BURKEY

Surveyed SEPT 19, 1973, by R. MUGGEN