


# T.10&11S., R.1W., W.M.

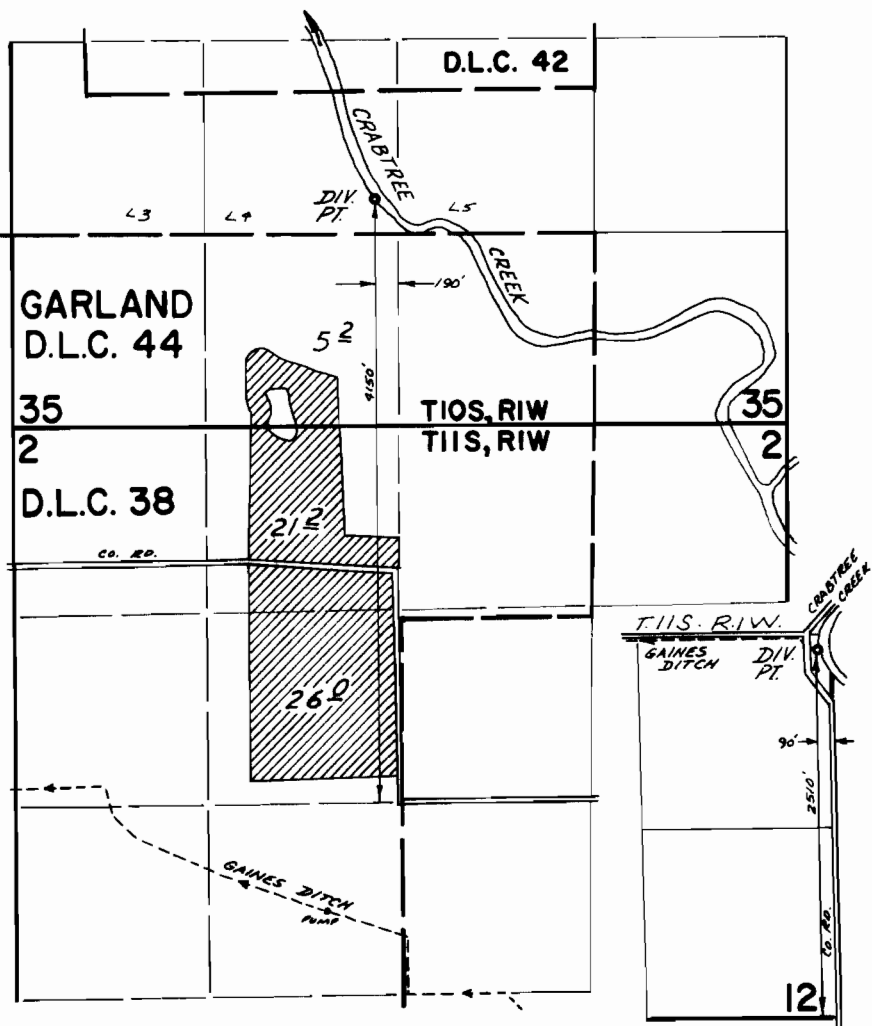

## FINAL PROOF SURVEY UNDER

Application No. 45388 Permit No. 33887  
IN NAME OF

BERNARD STEWART

Surveyed JUNE 20 1973, by D. NORBY