


T.11S., R.4W., W.M.

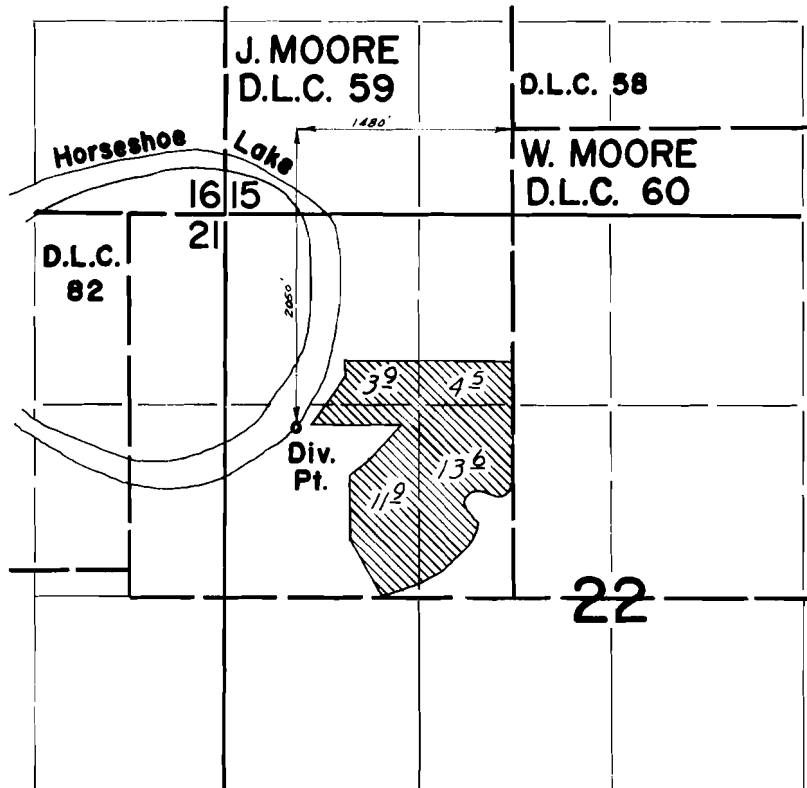

FINAL PROOF SURVEY
UNDER

Application No. 46362 Permit No. 34633
IN NAME OF

GEORGE L. AND LOUISE M. SCHLEGEL

Surveyed Oct. 1, 1973, by D. Norby