


T.8S.R.1W.W.M.

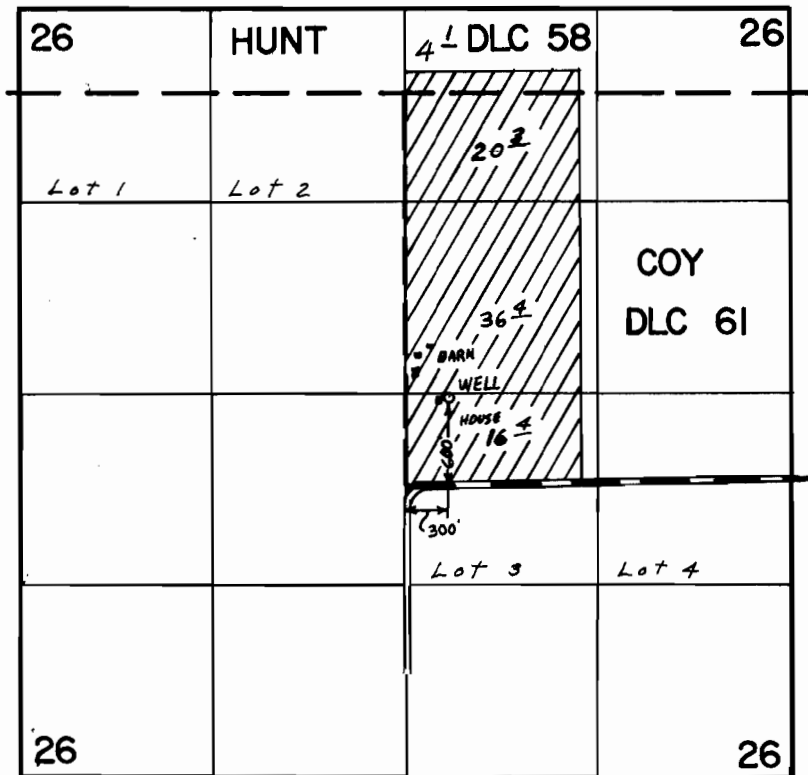

FINAL PROOF SURVEY UNDER

Application No. G-3438 Permit No. G-3155
IN NAME OF

MR. & MRS. GERALD HEUBERGER

Surveyed MAY 18 1973, by L.E. GOULD