


T.9S., R.1E., W.M.

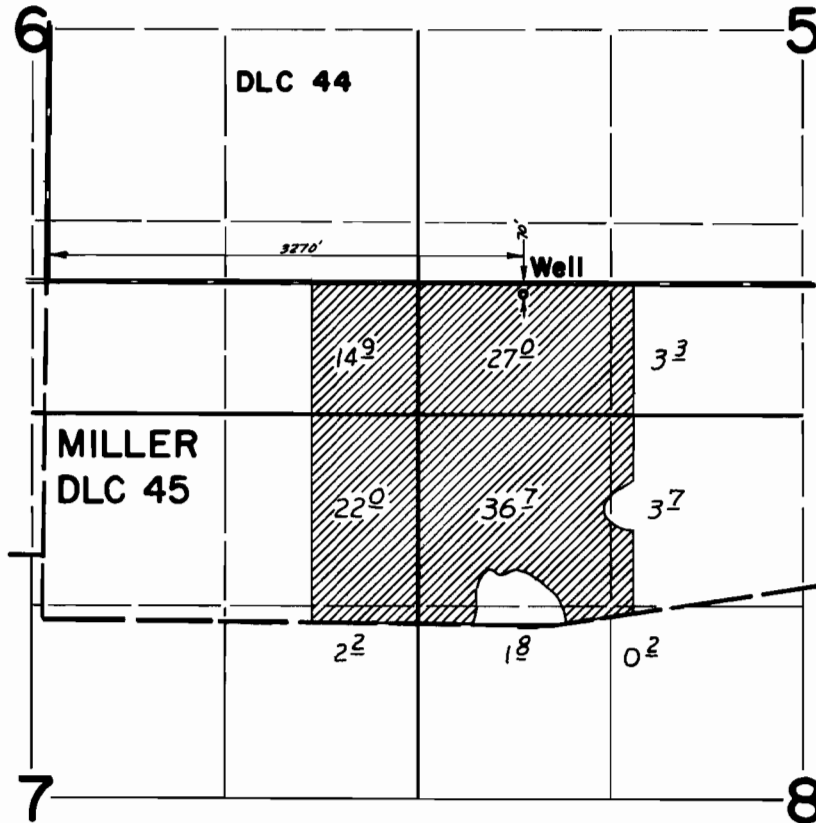

FINAL PROOF SURVEY UNDER

Application No. G-3454 Permit No. G-3260
IN NAME OF

DELLA BOEDIGHEIMER STURTEVANT

Surveyed July 5, 1973, by D. Norby