


T.7S. R.2W. W.M.

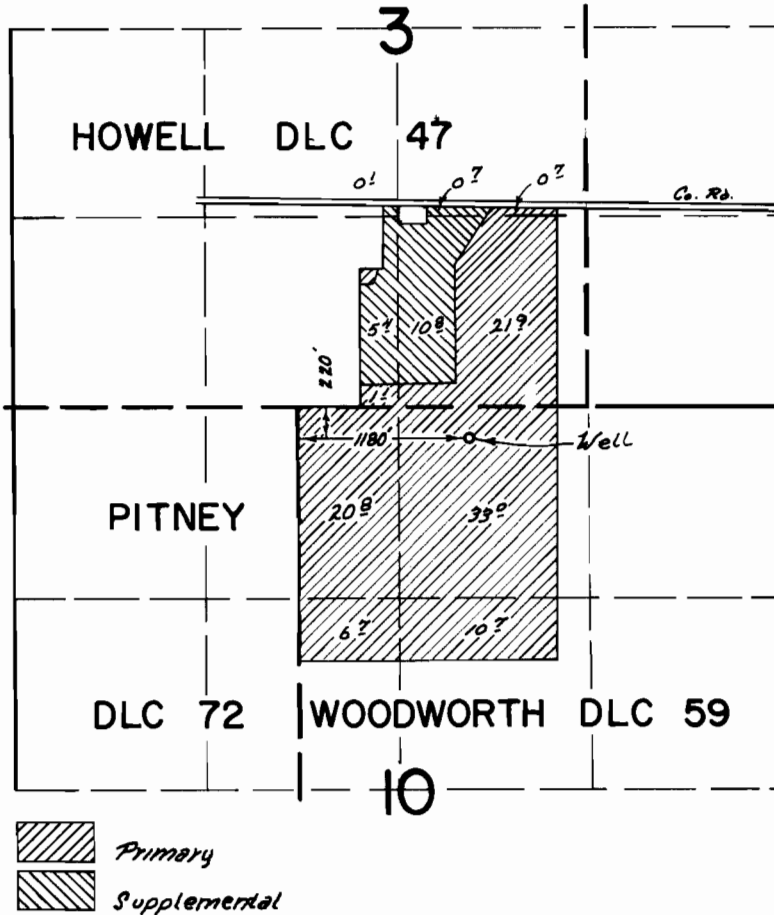

FINAL PROOF SURVEY
UNDER

Application No. 6-3480 Permit No. 6-3264
IN NAME OF

LEONARD W. ROTH

Surveyed May 31 1973, by T. J. Paul