


T.6S.R.2W.W.M.

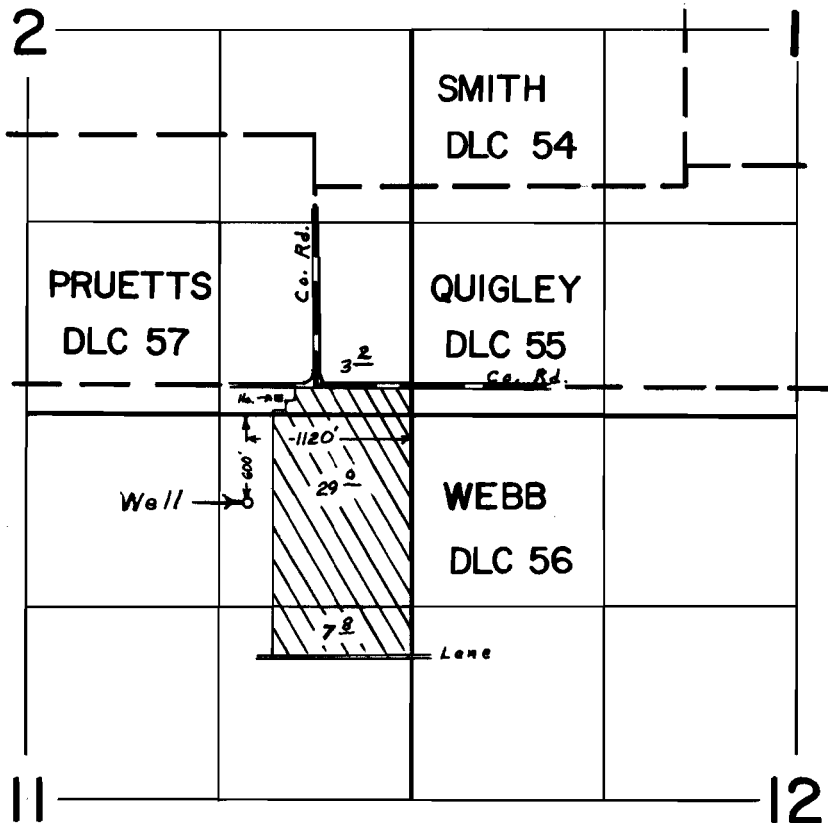

FINAL PROOF SURVEY UNDER

Application No. G-3501 Permit No. G-3298
IN NAME OF

ROBERT J. GRIESENHAUER

Surveyed MAY 15 1973, by T.J. PAUL