


T.7S. R.2W. W.M.

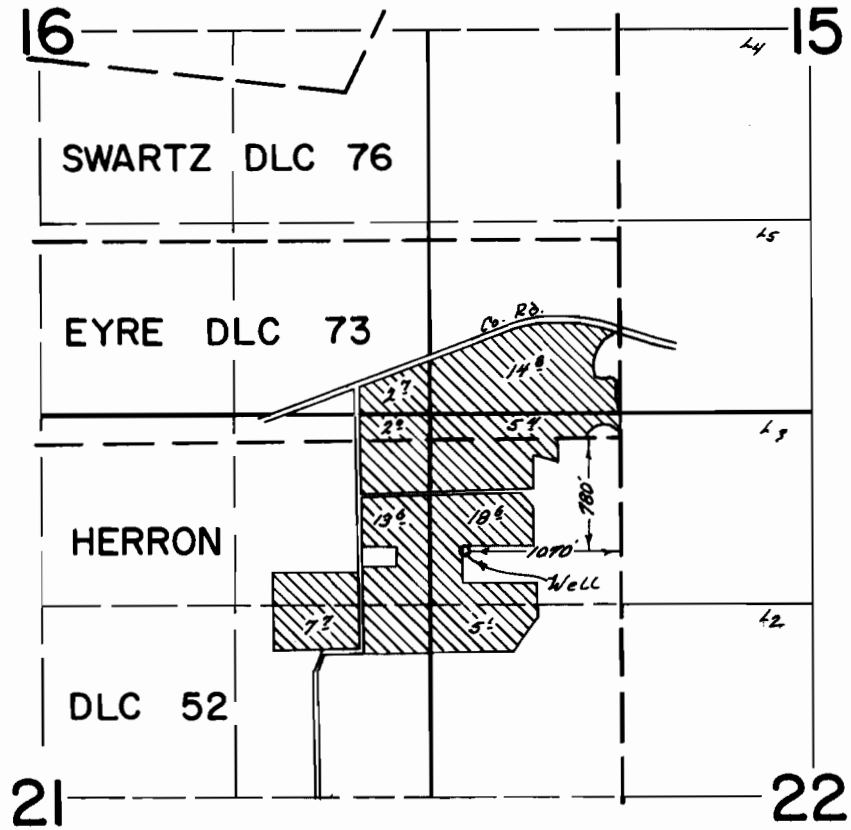

FINAL PROOF SURVEY
UNDER

Application No. C-3255 Permit No. G-3546
IN NAME OF

RAYMOND GERIG

Surveyed May 31 1973, by T.J. Paul