


T.4S. R.1W. W.M.

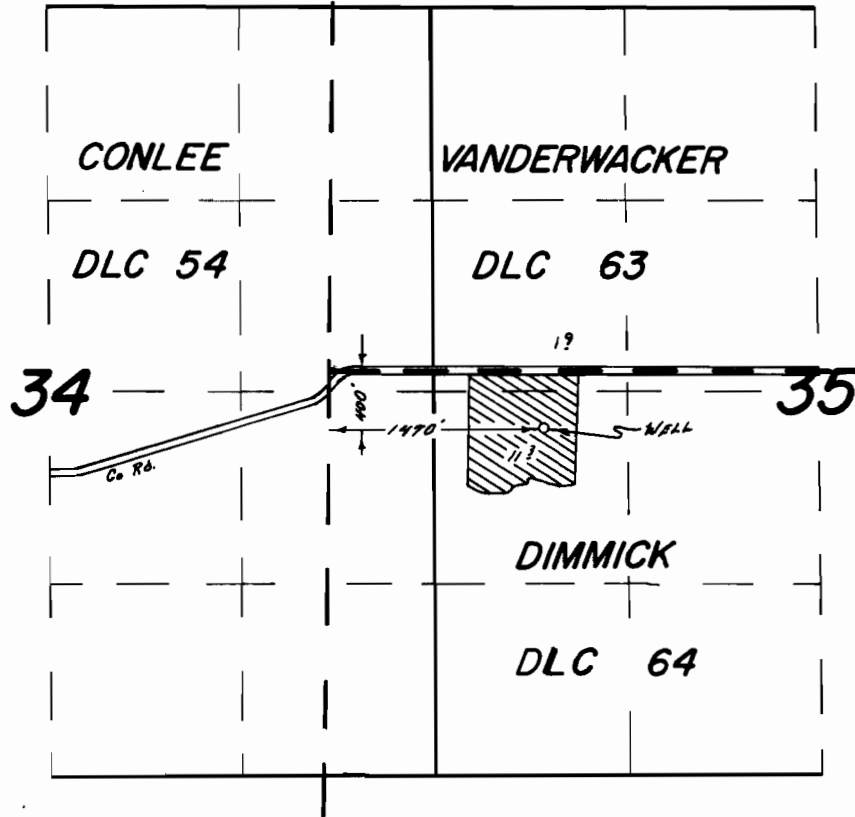

FINAL PROOF SURVEY
UNDER

Application No. G-3977 Permit No. G-3734
IN NAME OF

JOHN & VERA GARBER

Surveyed JUNE 8 19 73, by R. G. MUCKEN