T. 7S. R.2W. W.M.

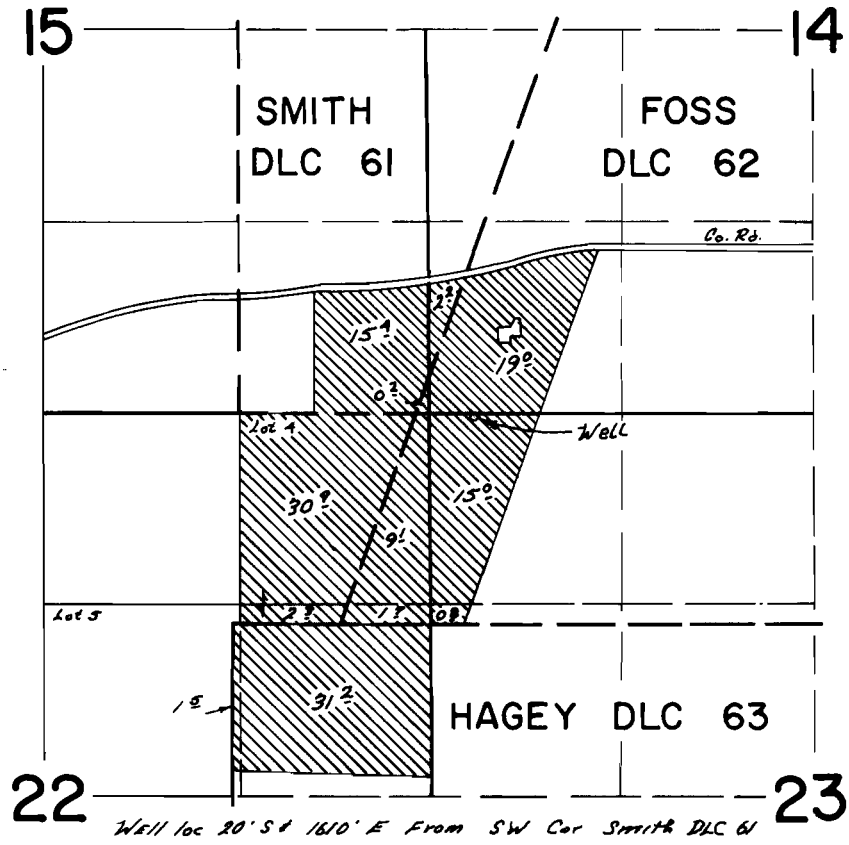

FINAL PROOF SURVEY
UNDER

Application No. G-1255 Permit No. G-3824
IN NAME OF

JOHN A. HAY

Surveyed June 1 19 78, by T.J. Paul

DFN-3LL-28