


T.7S. R.2W. W.M.

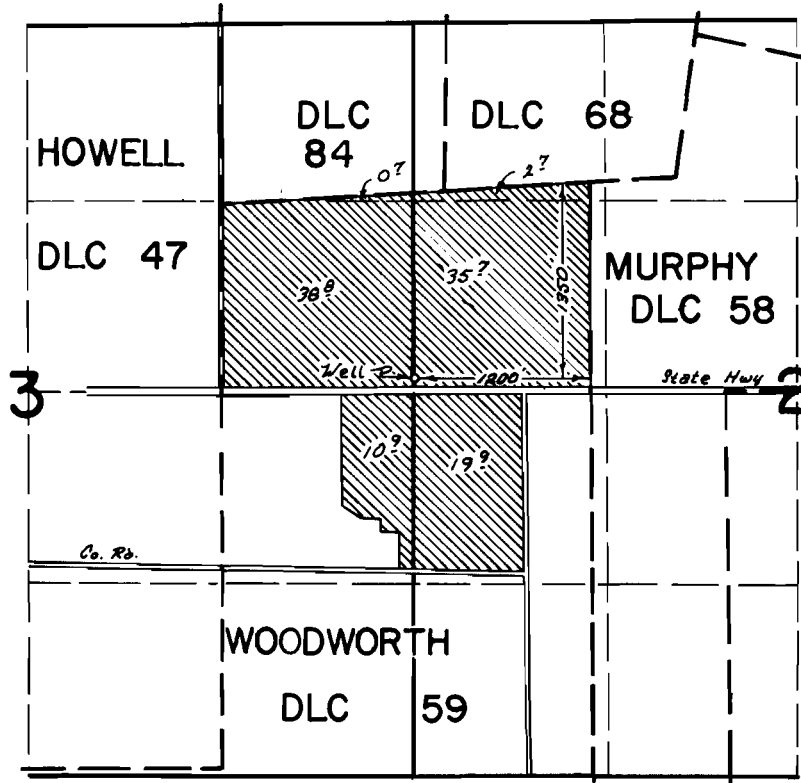

FINAL PROOF SURVEY
UNDER

Application No. G-4195 Permit No. G-3960
IN NAME OF

ROBERT ROTH

Surveyed June 1 1973, by T. J. Paul