


T.7S.,R.2W., W.M.

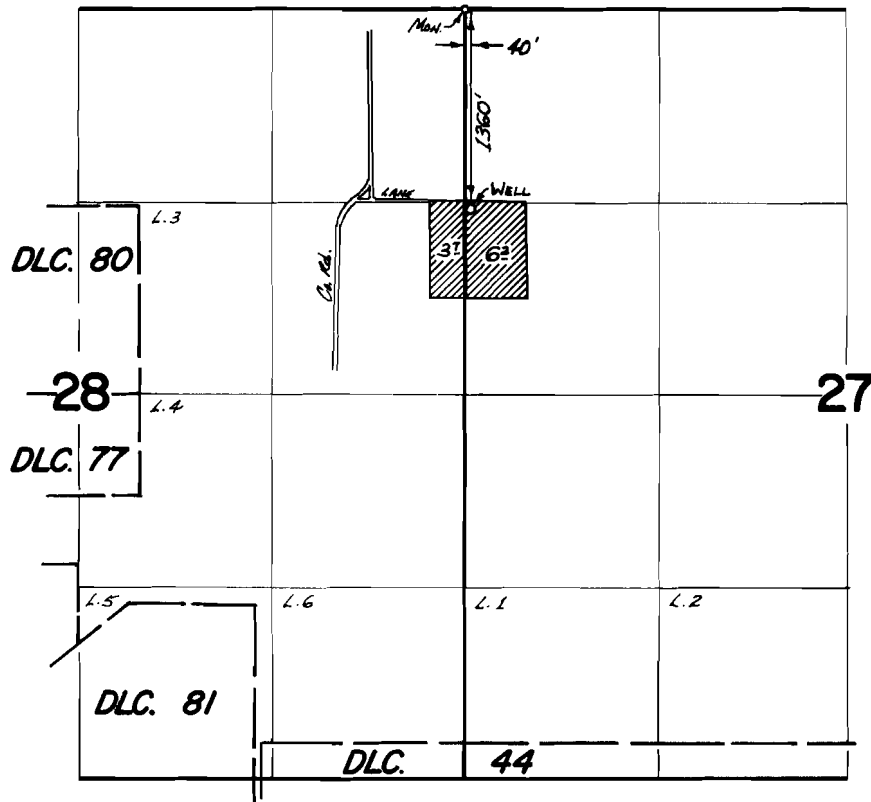

FINAL PROOF SURVEY
UNDER

Application No. G-4215 Permit No. G-3979
IN NAME OF

FRANCIS W. REHFELD

Surveyed Oct. 26 1973, by D. Norby