


T.7S. R.2W. W.M.

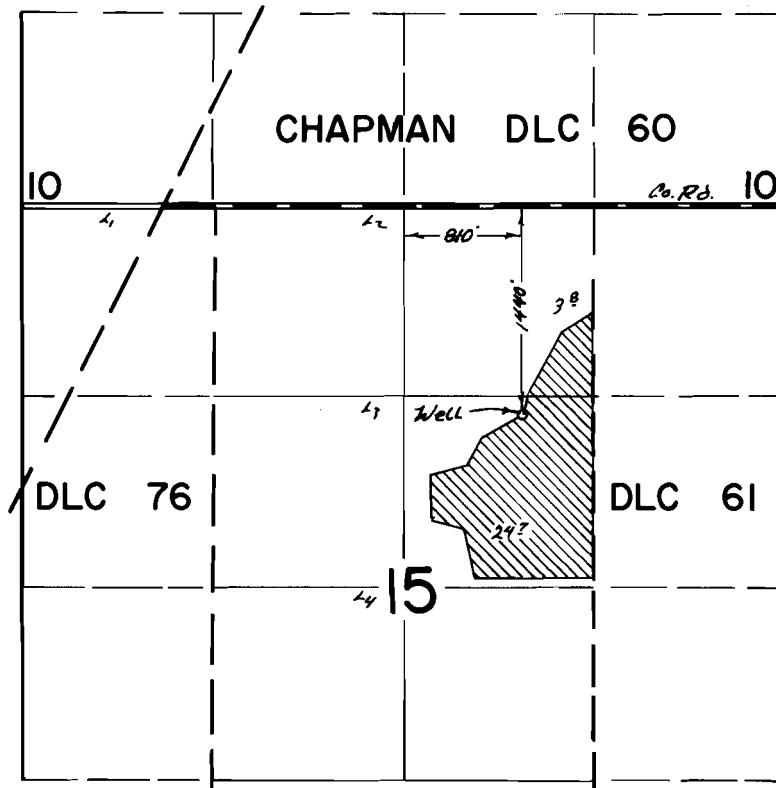

FINAL PROOF SURVEY
UNDER

Application No. 0-4189 Permit No. 0-4099
IN NAME OF

EARL V. HAMMER

Surveyed June 1 1973, by T J Pool