


T.7S. R.2W. W.M.

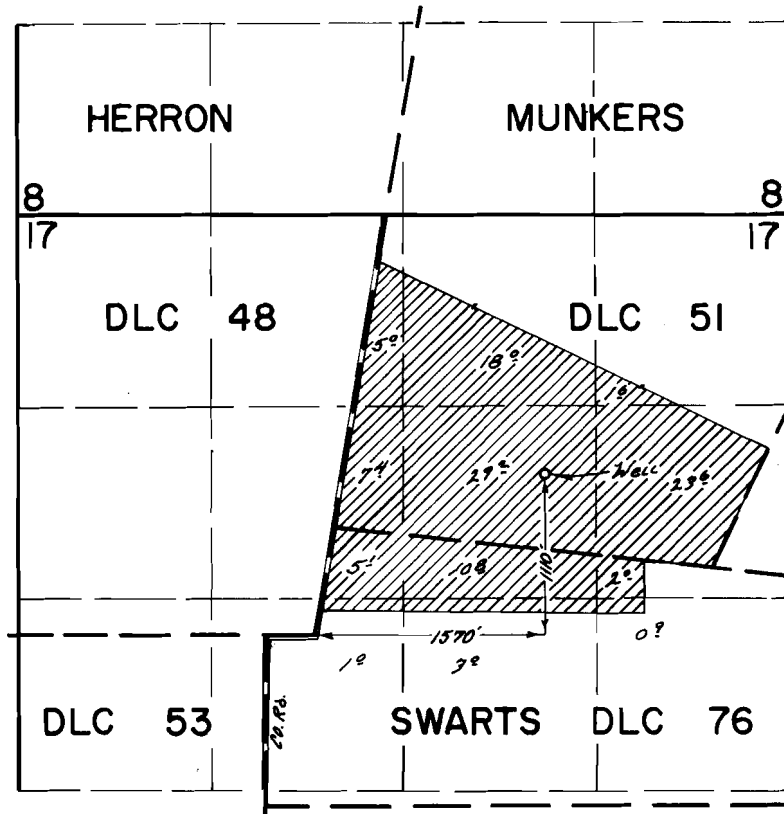

**FINAL PROOF SURVEY**  
UNDER

Application No. G-4995 Permit No. G-4090

IN NAME OF

ALTON ROTH

Surveyed May 31 1978, by T.J. Paul