


T.5S. R.1&2W. W.M.

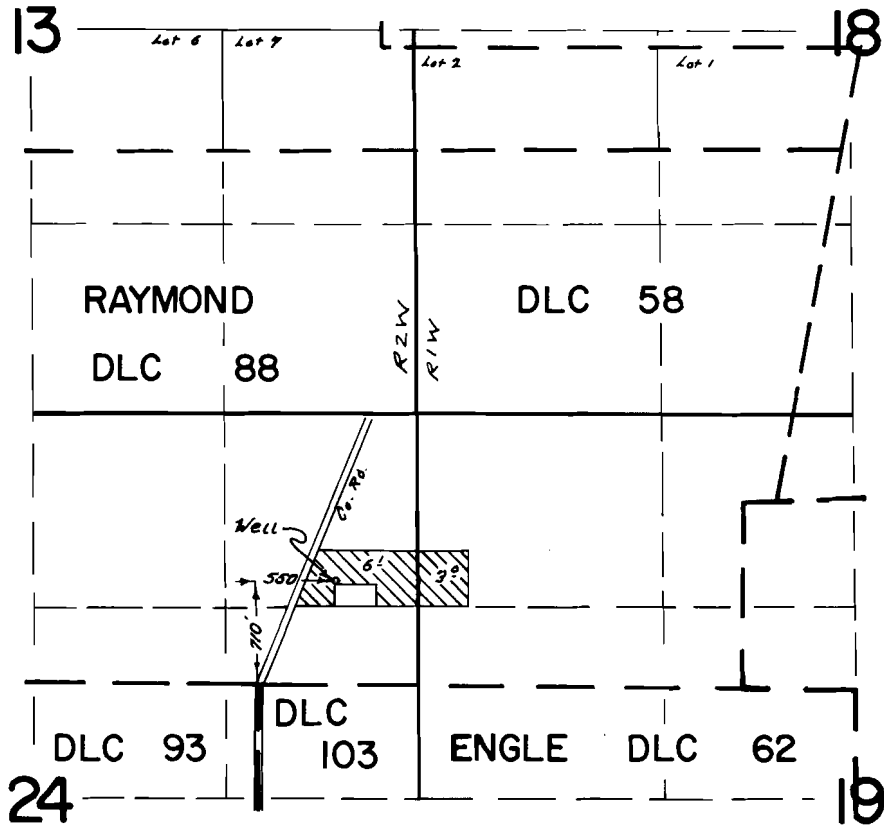

**FINAL PROOF SURVEY**  
UNDER

Application No. G-4342 Permit No. G-4099  
IN NAME OF

FRANCIS CHARLES BORCHERS

Surveyed May 18 1973, by T. J. Paul