


T.9S., R.1E., W.M.

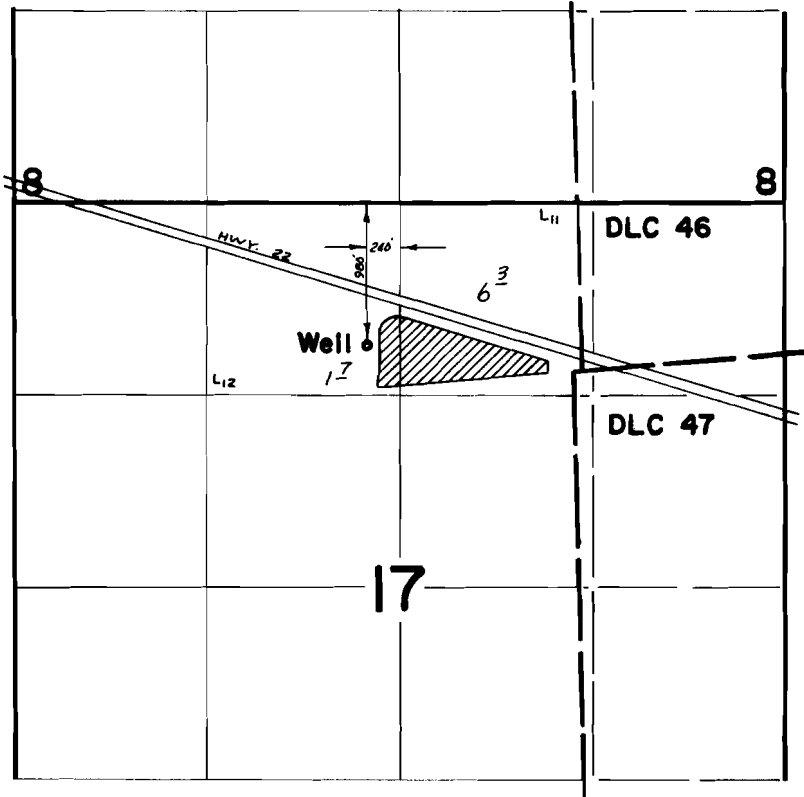

FINAL PROOF SURVEY UNDER

Application No. G-4344 Permit No. G-4101
IN NAME OF

MAURICE SUNDERMAN

Surveyed July 5, 1973, by D. Norby