


T.7S. R.2W. W.M.

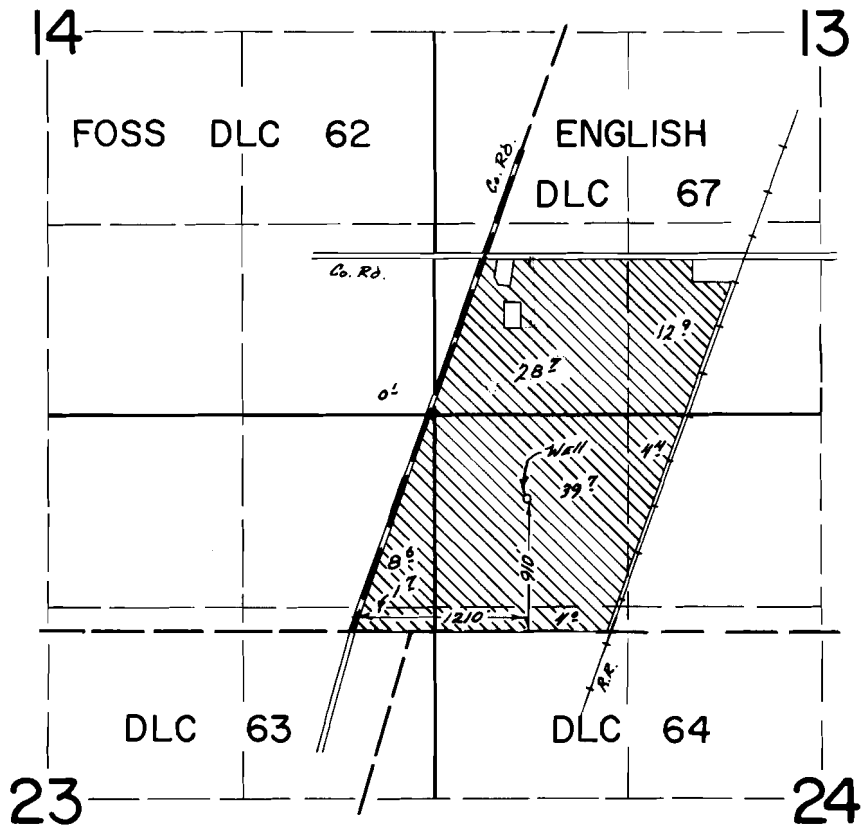

FINAL PROOF SURVEY
UNDER

Application No. G-4470 Permit No. G-4212

IN NAME OF

CECIL ROTH

Surveyed May 31 1979, by J.P. 201