


T.5S. R.2W. W.M.

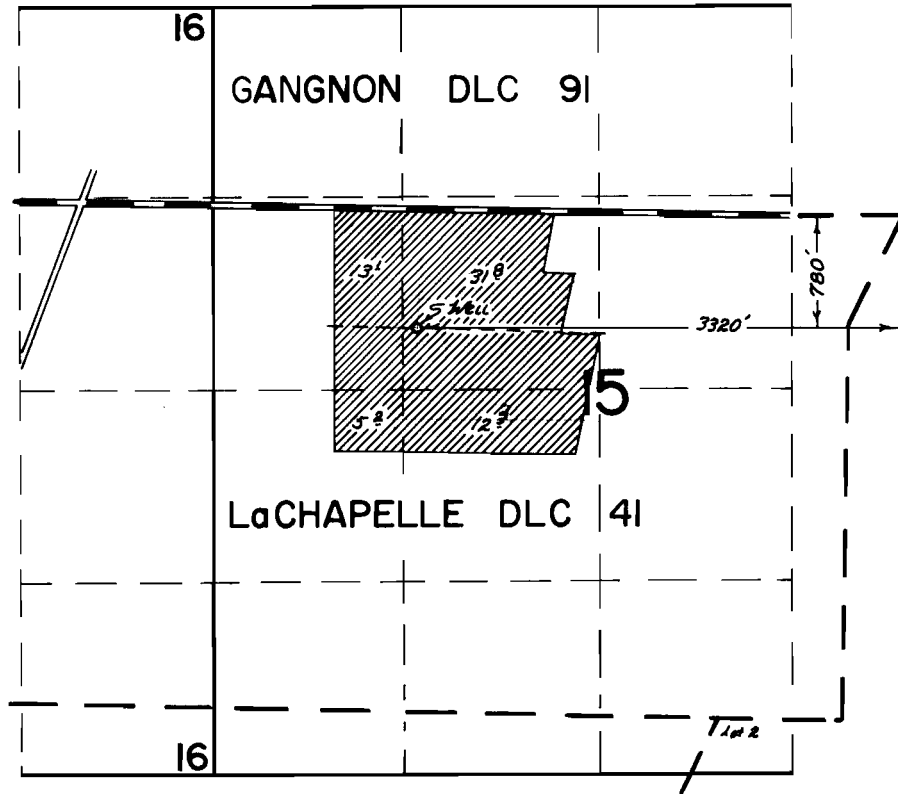


FINAL PROOF SURVEY
UNDER

Application No. G-4492 Permit No. G-4234
IN NAME OF

LEONARD R. FERSCHWEILER

Surveyed May 22 1973, by T.J. Paul

T.5S. R.2W. W.M.

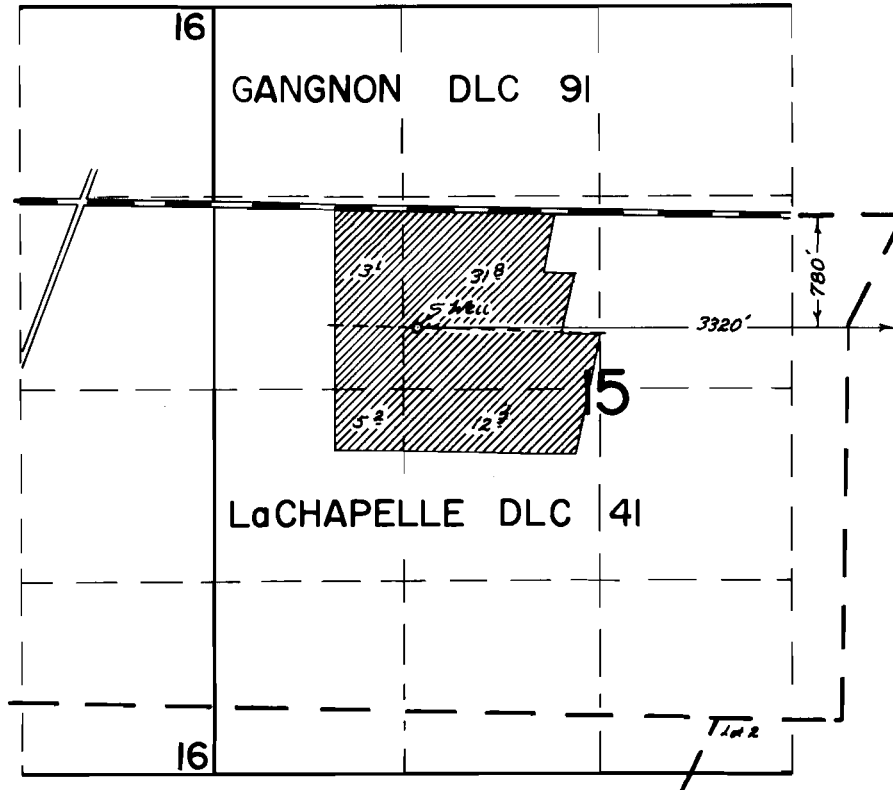

FINAL PROOF SURVEY
UNDER

Application No. B-4492 Permit No. B-4234
IN NAME OF

LEONARD R. FERSCHWEILER

Surveyed Nov. 22, 1979, by T.J. Peck