


T. 9S., R. 1E., W.M.

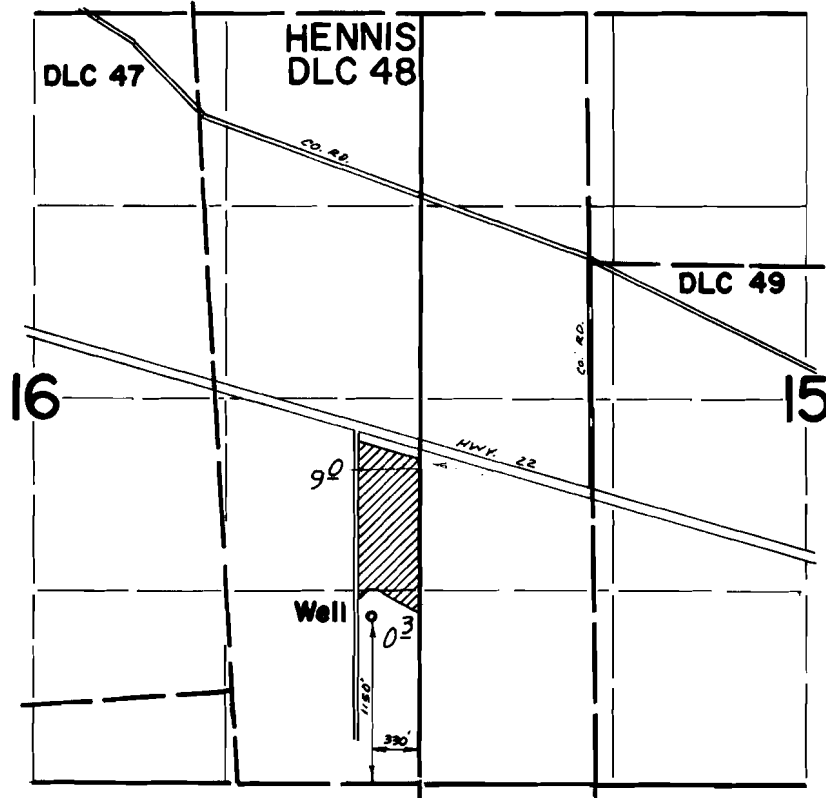

FINAL PROOF SURVEY
UNDER

Application No. G-4502 Permit No. G-4244
IN NAME OF

VERNON R. MORGAN

Surveyed July 3, 1973, by D. Norby