T.4S. R2W. W.M.

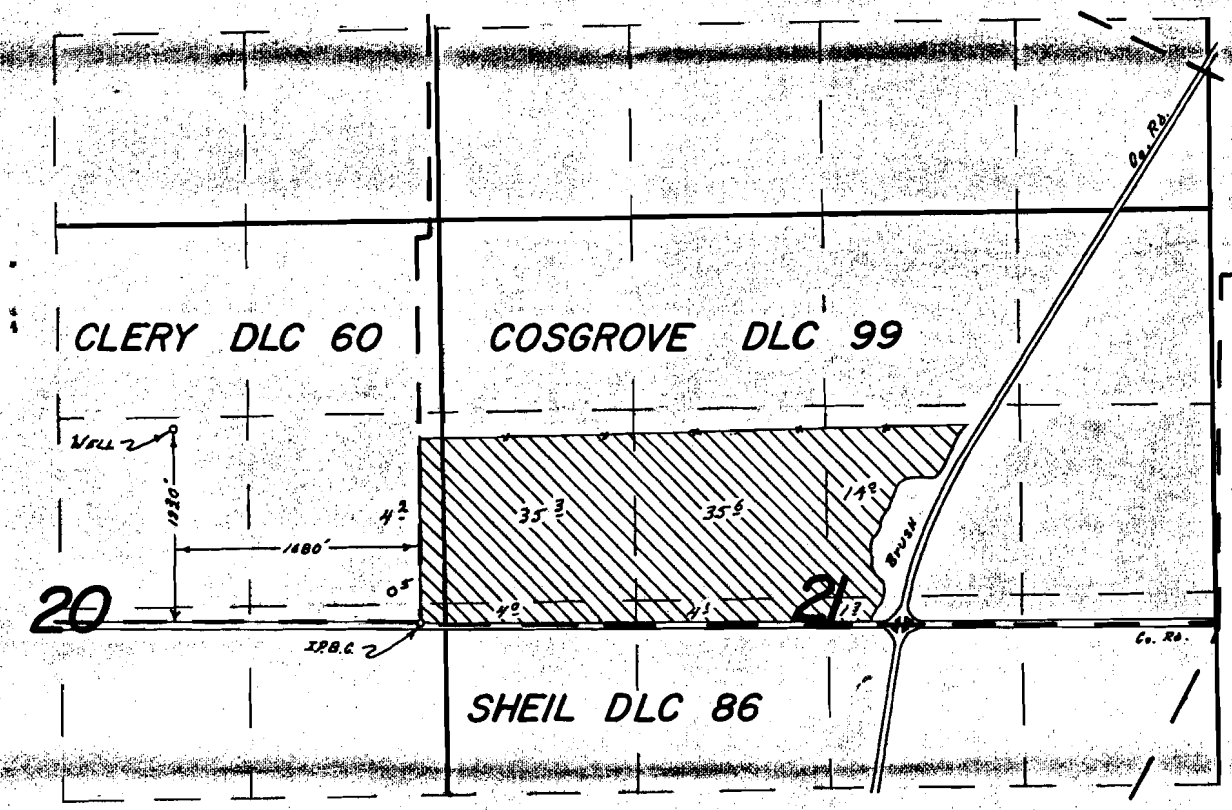

FINAL PROOF SURVEY
UNDER

Application No. 6-4706 Permit No. 6-4512
IN NAME OF

ELMER GOODING

Surveyed May 15 19 73, by R.G. MUCKEN

DAN-5LC-254 & 6LL-130 TP