


T.7S. R.2W. W.M.

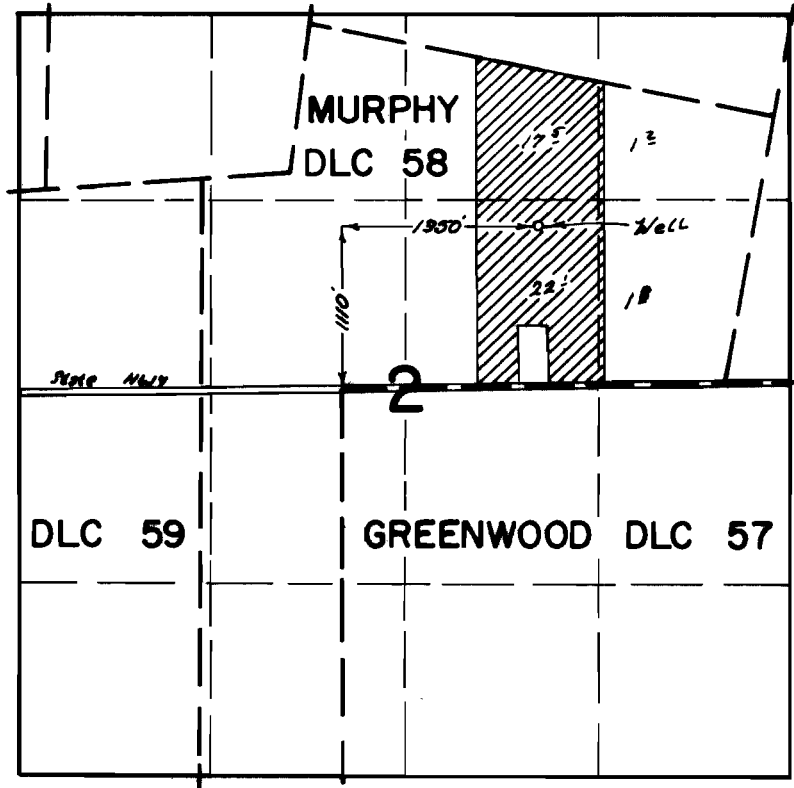

FINAL PROOF SURVEY
UNDER

Application No. G-4878 Permit No. G-4559
IN NAME OF

DONALD D. KUENZI

Surveyed May 31 1977, by T.J. Paul