


T.5S. R.2W. W.M.

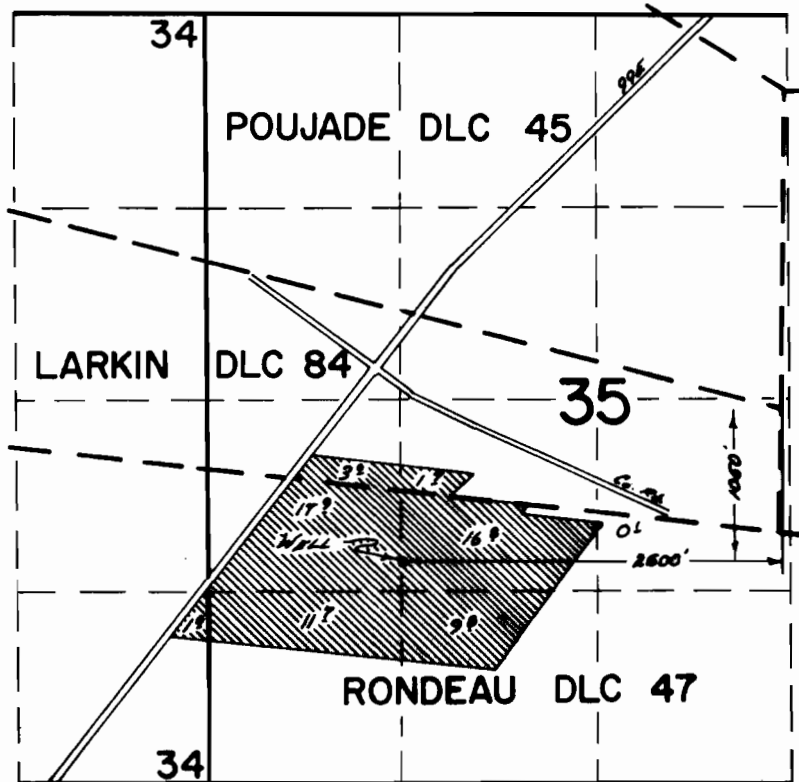

FINAL PROOF SURVEY
UNDER

Application No. B-4850 Permit No. C-4587
IN NAME OF

ANTON ADELMAN

Surveyed May 22 1978, by T. J. Paul