


T.9S.R.2W.W.M.

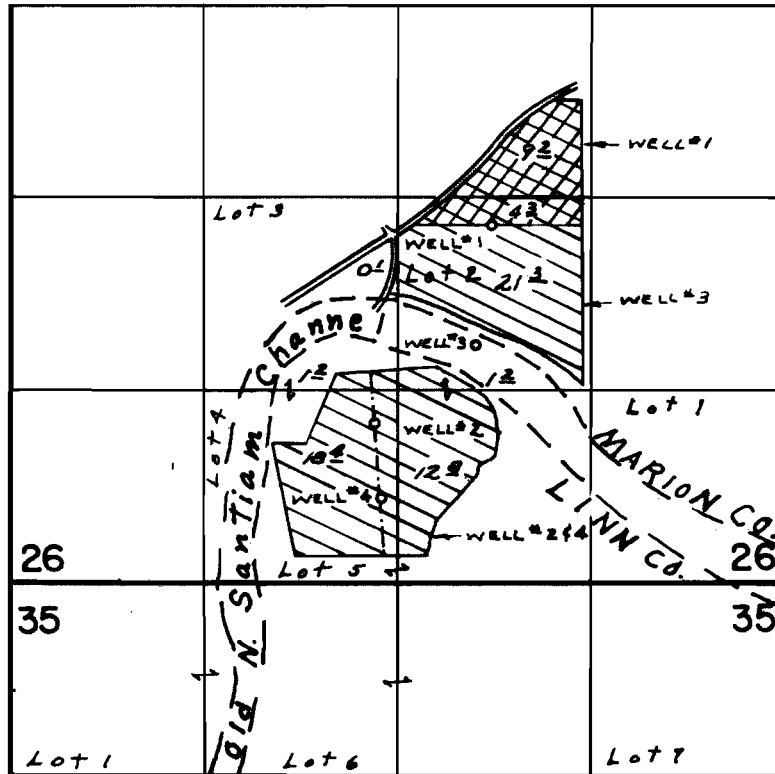

WELLS LOC: #1- 2000'W & 2480'N; #2- 2400'W & 1090'N;  
#3- 2120'W & 1630'N; #4- 2760'W & 580'N, ALL FROM  
S.E. COR. SEC. 26

**FINAL PROOF SURVEY**  
UNDER

Application No. G-4888 Permit No. G-4609  
IN NAME OF

MERLE CRANE

Surveyed MAY 16 1973, by L.E. GOULD