


# T.7S. R.2W. W.M.

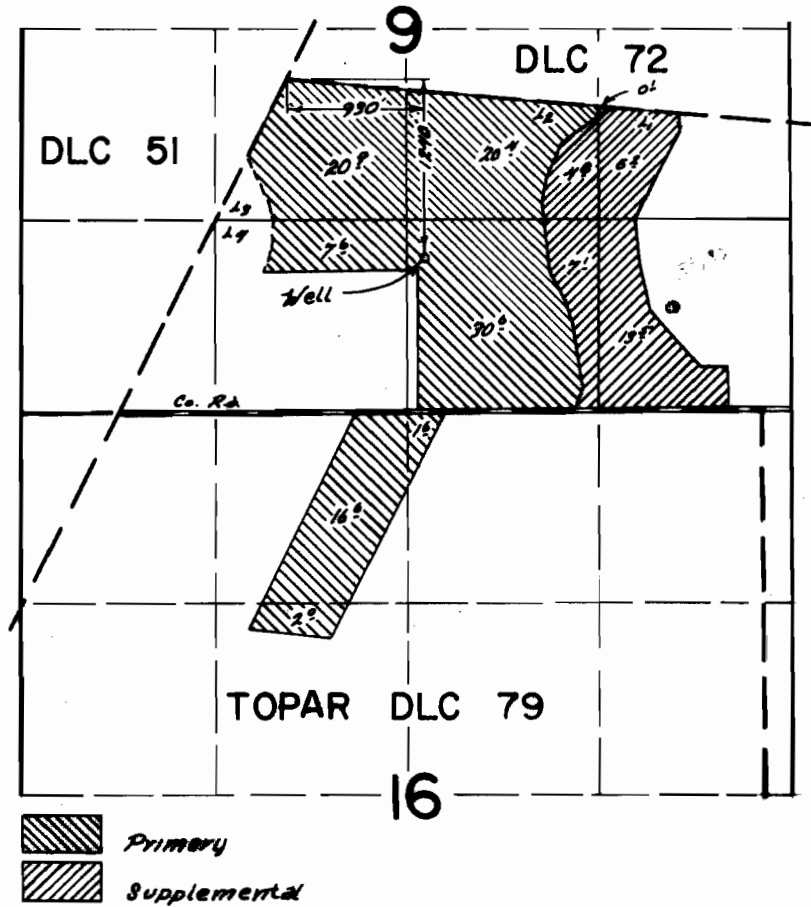

## FINAL PROOF SURVEY UNDER

Application No. G-4912 Permit No. G-4629  
IN NAME OF

H. C. TOELIE

Surveyed Nov 31 1979, by T.J. Paul