


T.4S. R.1W. W.M.

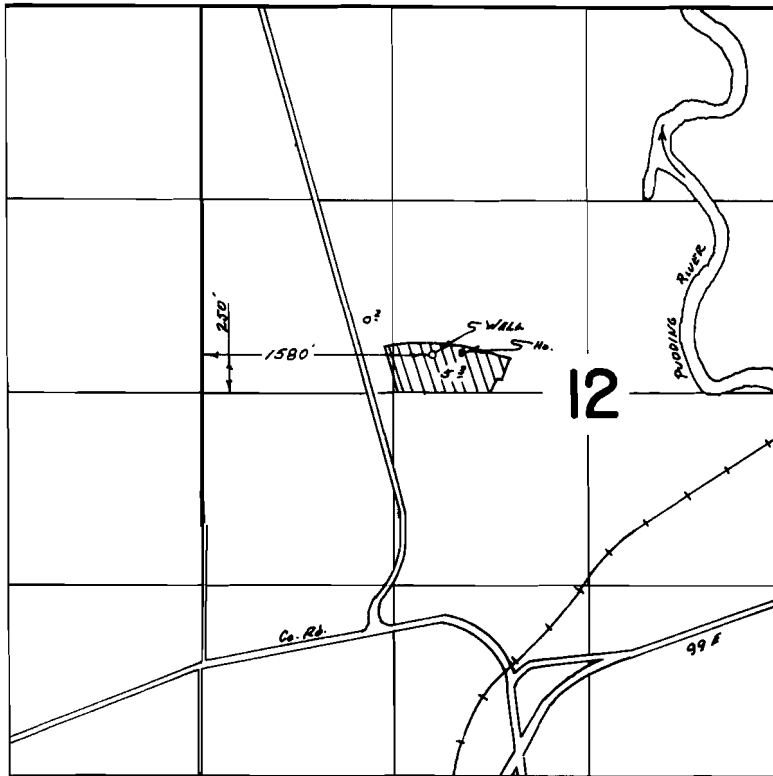

FINAL PROOF SURVEY UNDER

Application No. B-5258 Permit No. G-4830
IN NAME OF

CHARLES DALE CATTON

Surveyed MAY 25 1973, by T. J. PAUL