T. 8 S. R. 3 W. W.M.

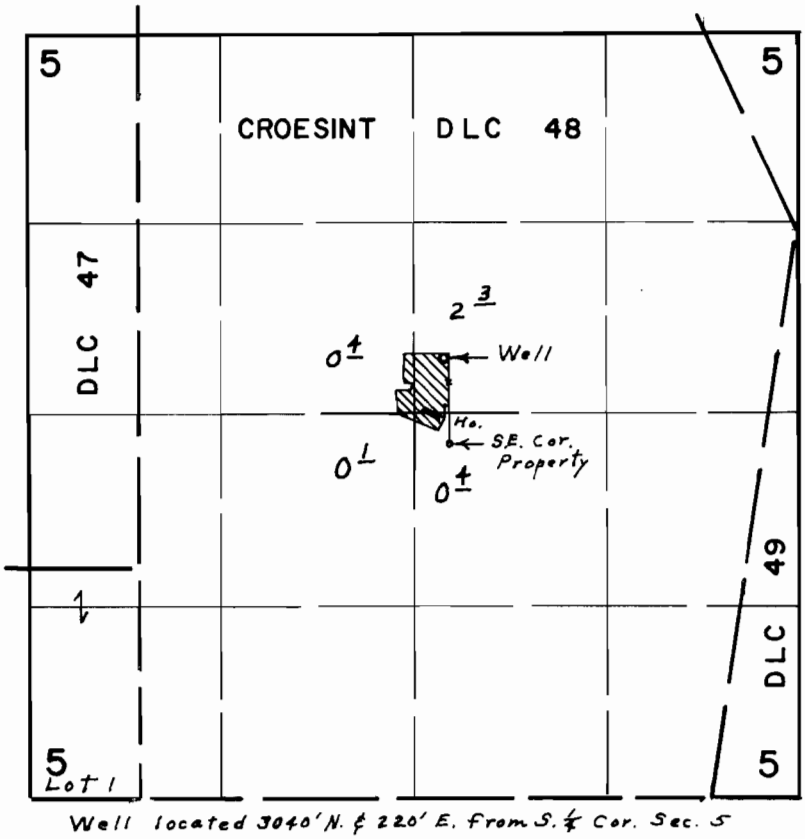

FINAL PROOF SURVEY
UNDER

Application No. G-5445 Permit No. G-4843
IN NAME OF

EDGAR A. KUPILLAS

Surveyed May 15, 1973, by L. E. Gould

1973-S