


T.7S., R.2W., W.M.

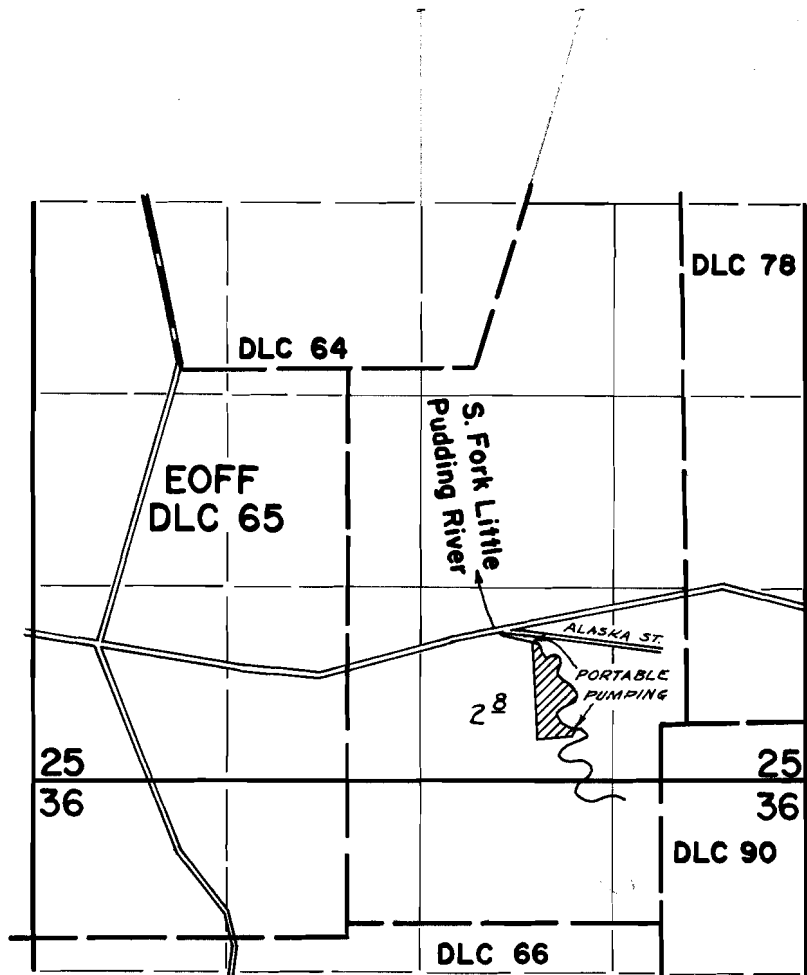

PORTABLE PUMPING LOCATED FROM A POINT 2480'S & 1560'E TO A POINT 1890'S & 1260'E, BOTH FROM 54' NE COR. EOFF DLC 65.

**FINAL PROOF SURVEY**  
UNDER

Application No. 44275 Permit No. 33001  
IN NAME OF

ALLEN A. AND CAROLE S. RITCHEY

Surveyed April 6, 1973, by D. Norby