


# T. 6 S. R. 1 W. W. M.

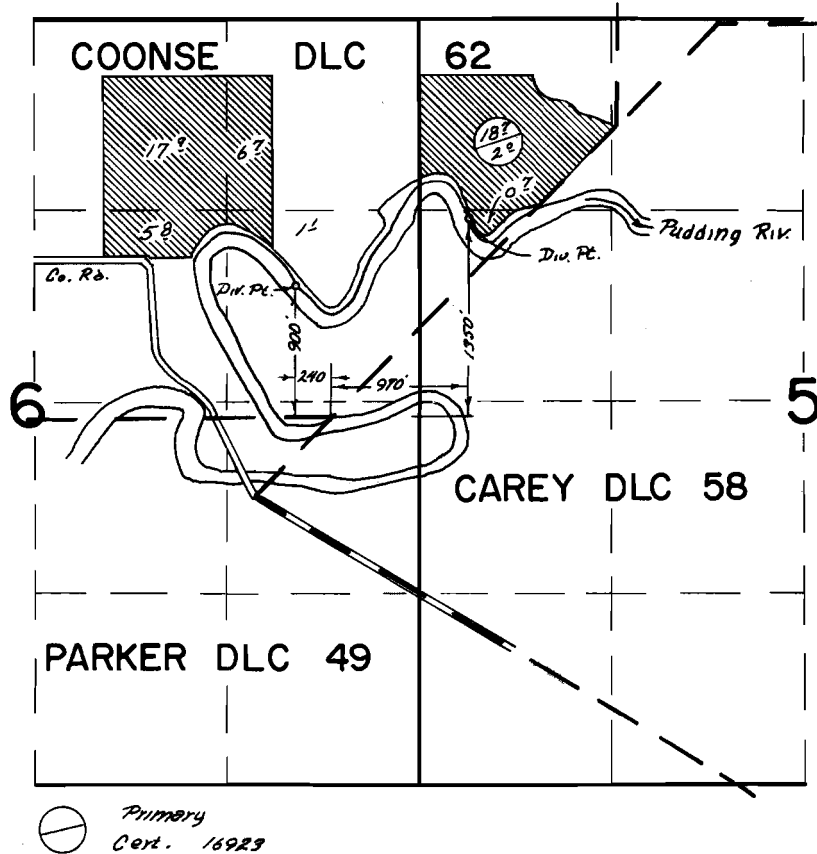

## FINAL PROOF SURVEY UNDER

Application No. 44599 Permit No. 33978  
IN NAME OF

ANDREW EDER

Surveyed May 23 19 73, by T. J. Paul