


# T. 7S. R.I.E. W.M.

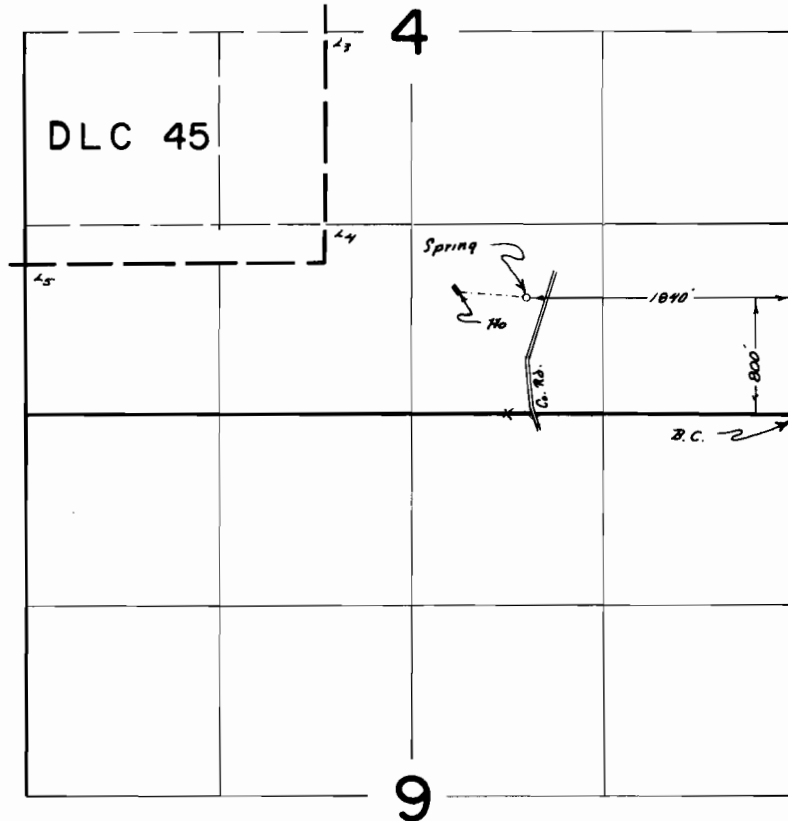

## FINAL PROOF SURVEY UNDER

Application No. 44975 Permit No. 33618  
IN NAME OF

JAMES A. & SHIRLEY G. MEITHOF

Surveyed Oct. 4 1973, by R.G. Mucken