


T. 9 S., R. 1 E., W. 1 M.

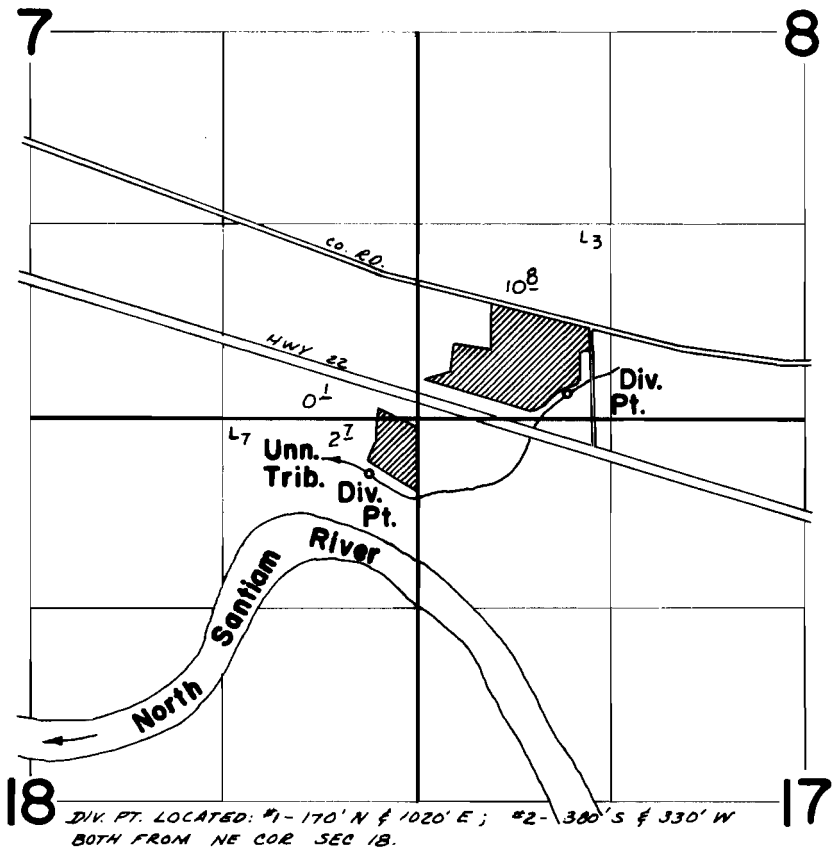

FINAL PROOF SURVEY
UNDER

Application No. 46137 Permit No. 34469
IN NAME OF

AL SILBERNAGAL

Surveyed July 3, 1973, by D. Norby