


T.7S. R.1E. W.M.

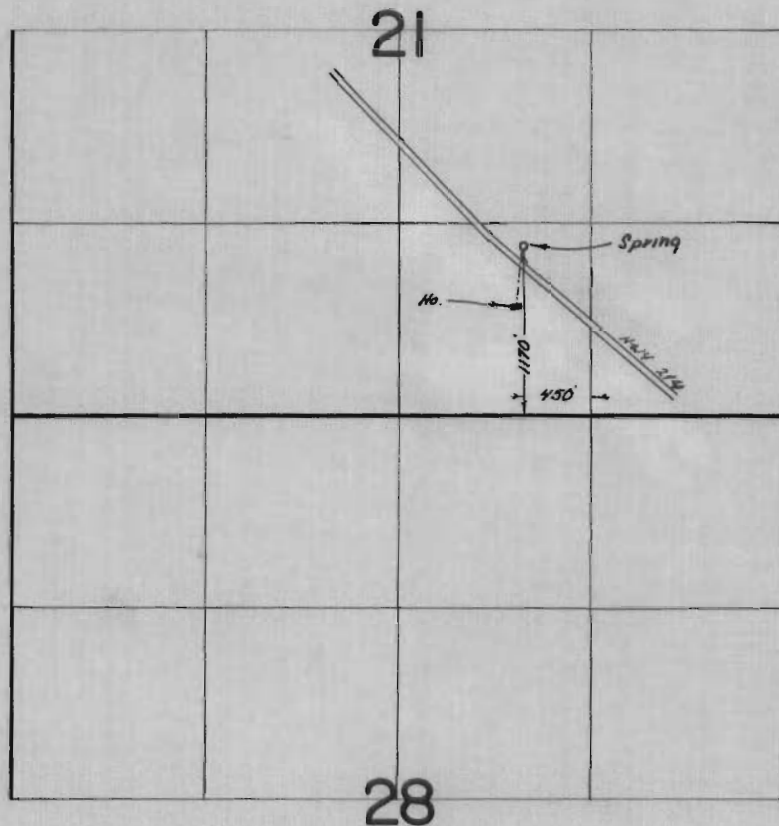

FINAL PROOF SURVEY
UNDER

Application No. 47676 Permit No. 35682
IN NAME OF

DONALD REINHART

Surveyed July 5 1973, by R.G. Mucken