


T. 8 S. R. 4 W. W. M.

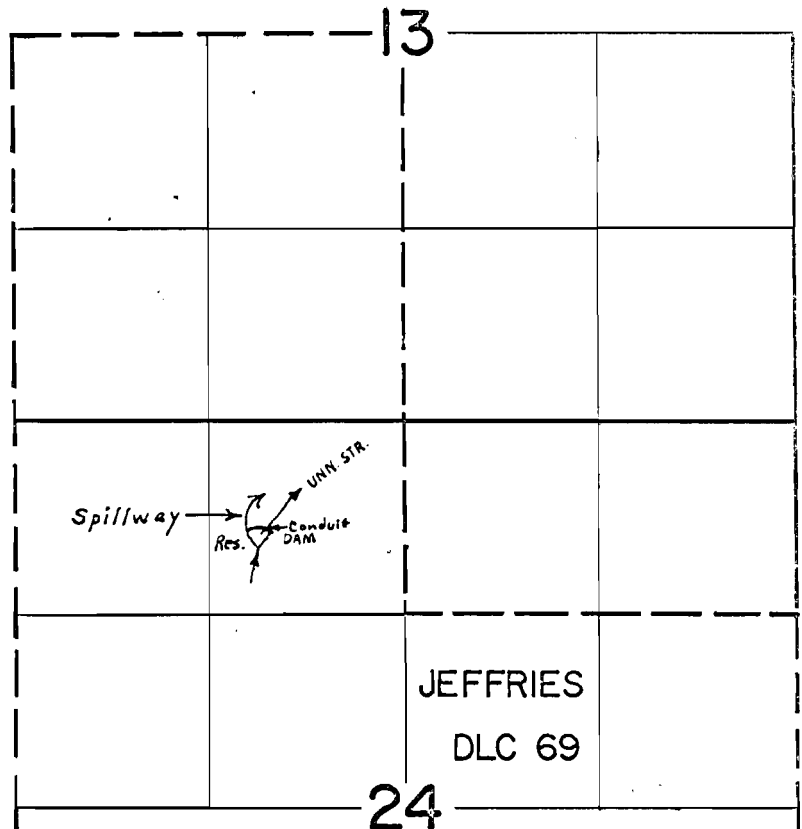

DIV. PT. 3370' S AND 1720' E FROM NW. COR. JEFFRIES D.L.C. 69

FINAL PROOF SURVEY
UNDER

Application No. R-42906 42907 Permit No. R-4748 31269
IN NAME OF

KIM & PAULA R. HYATT

Surveyed MAY 15 19 73, by L. E. GOULD