


T. 7 & 8 S. R. 1 W. W.M.

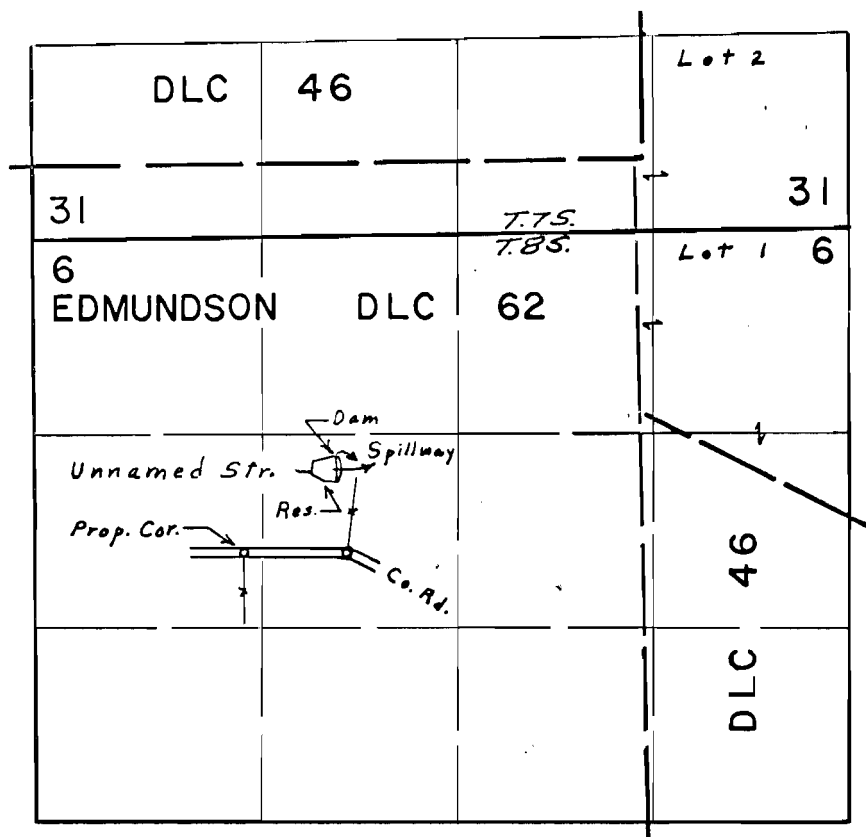

Div. Pt. located 2080' S. & 1960' W. from N.E. Cor. Edmundson D.L. C. 62

FINAL PROOF SURVEY UNDER

R-44905 R-5261
Application No. 44906 Permit No. 33278
IN NAME OF

JERRY R. & SHARON M. CROXEN

Surveyed July 3, 1973, by L. E. Gould