


T. 7 & 8 S. R. I W. W.M.

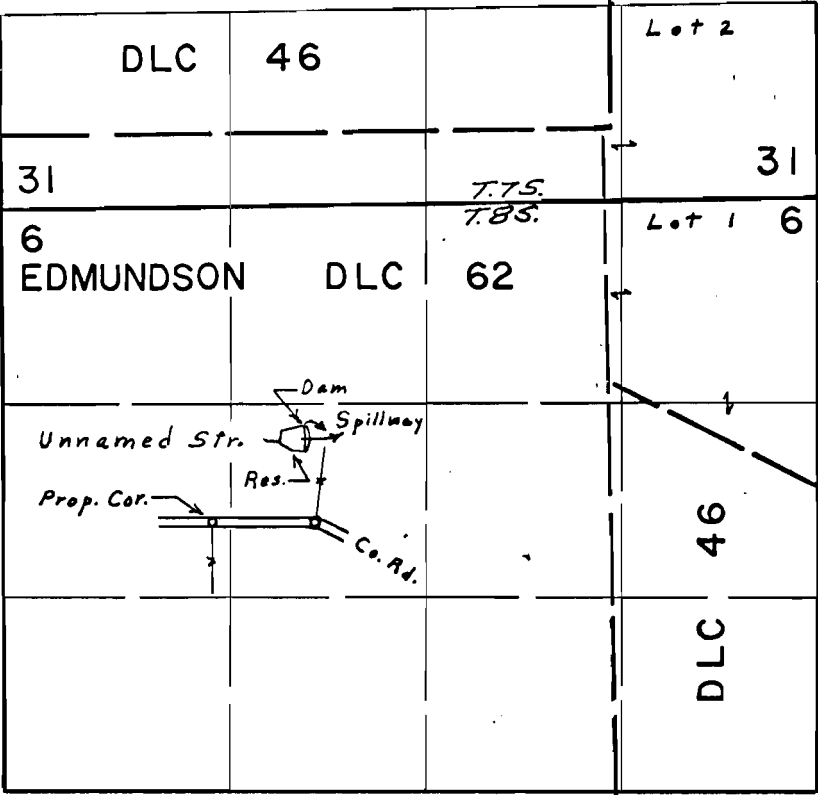

Div. Pt. located 2080' S. & 1960' W. from N.E. Cor. Edmondson D.L.C. 62

FINAL PROOF SURVEY
UNDER

Application No. R-44905 44906 Permit No. R-5261 33278
IN NAME OF

JERRY R. & SHARON M. CROXEN

Surveyed July 3, 1973, by L. E. Gould.