


T.7S., R.2W., W.M.

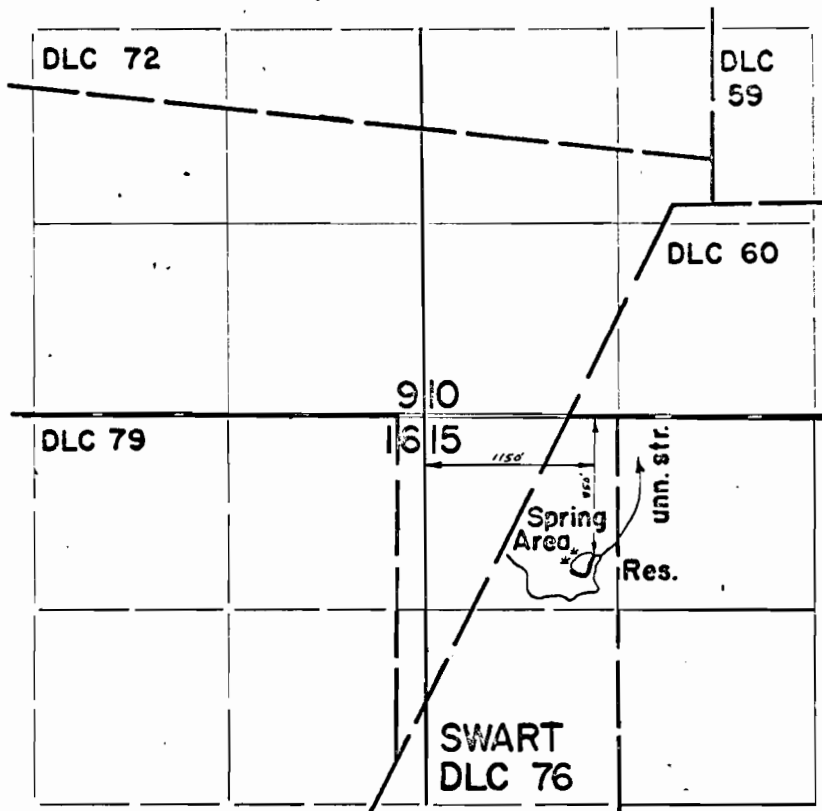

FINAL PROOF SURVEY
UNDER

R-47459 R-5719
Application No. 47460 Permit No. 35554
IN NAME OF

LOUIS SIERZEGA

Surveyed April 6, 1973, by D. Norby