


T.2S. R.24&25E. W.M.

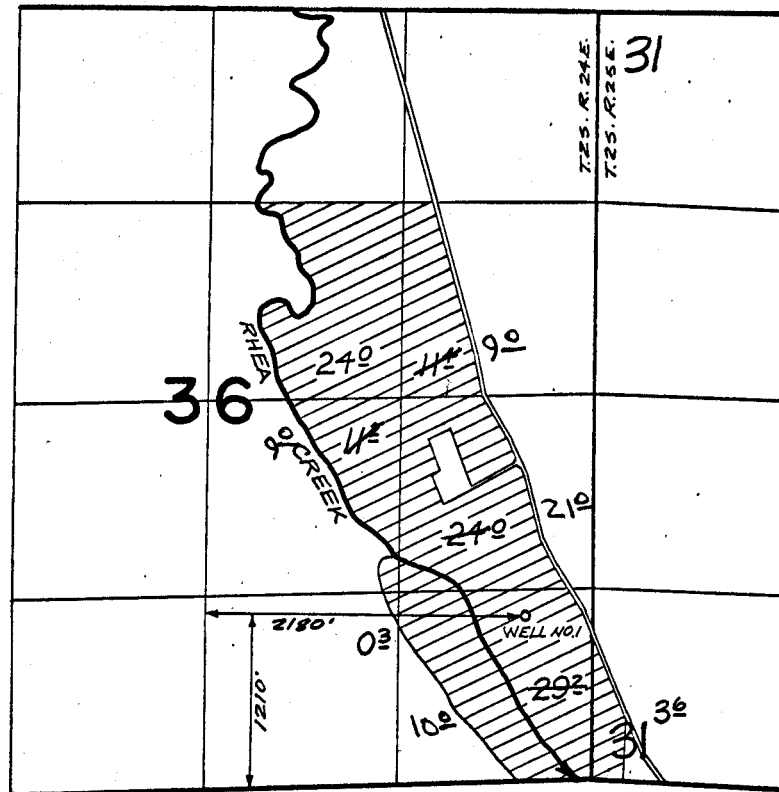

FINAL PROOF SURVEY UNDER

Application No. G4641 Permit No. G4366
IN NAME OF

TERREL L. BENGE

Surveyed MAY 9 1974, by D. NORBY