


G-4369
42250

T. 1S., R. 24E., W.M.

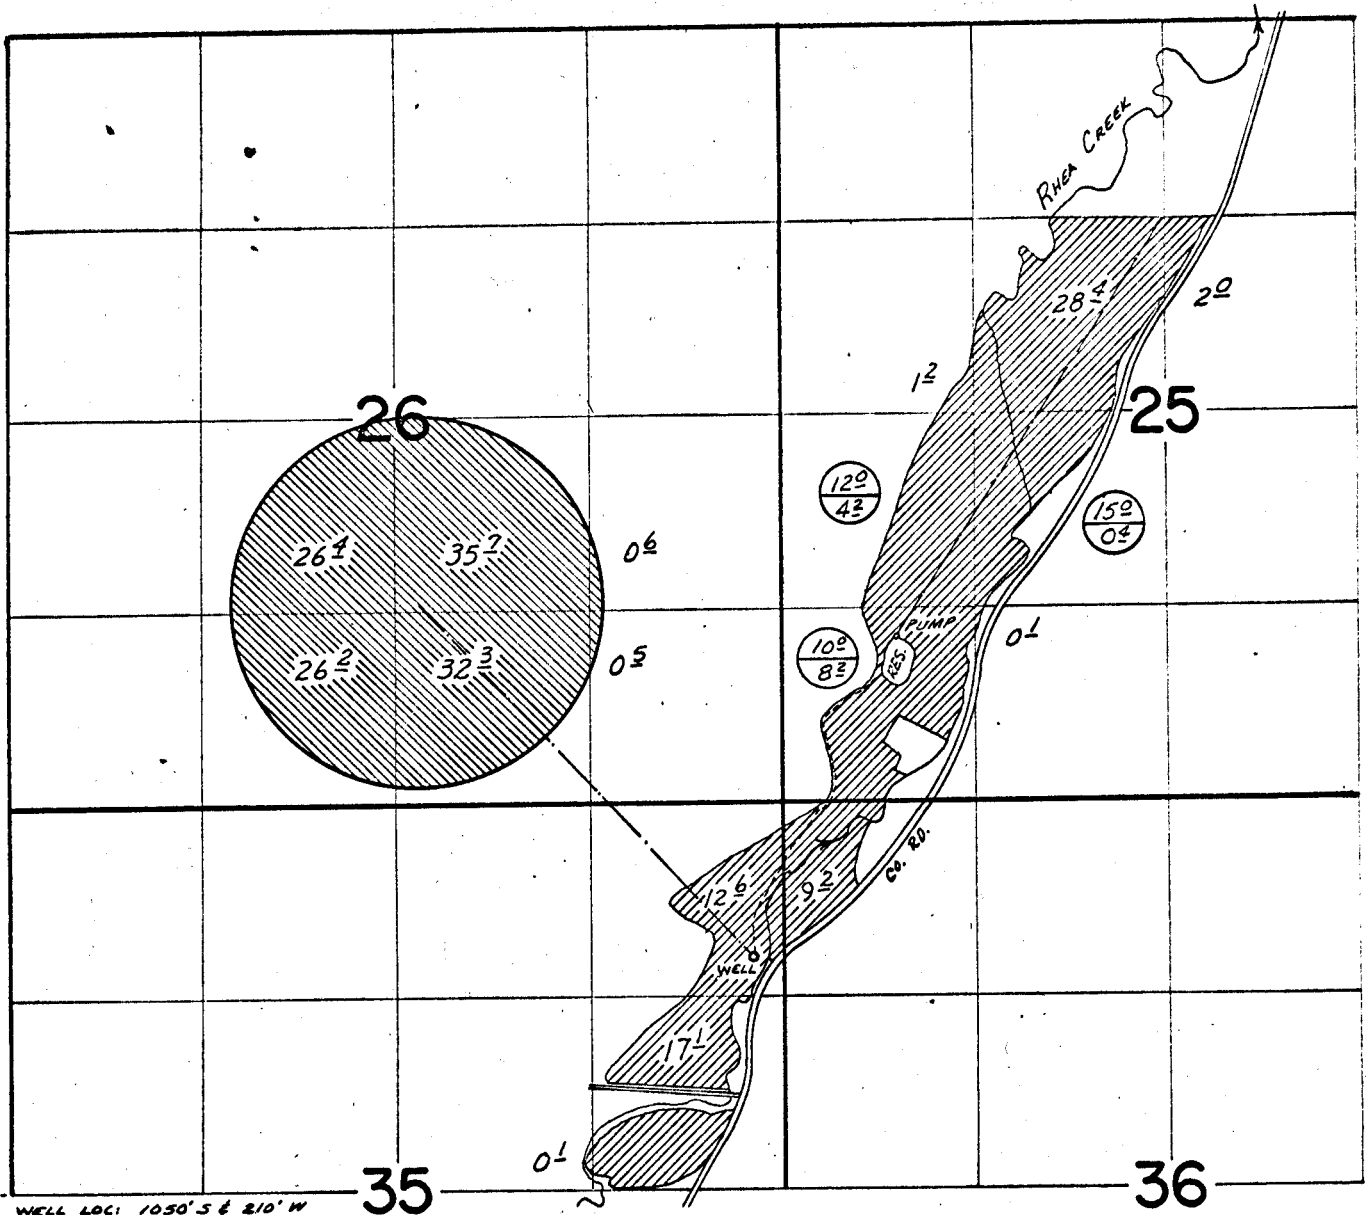


WELL LOC: 1050' S & 210' W
FROM NE COR SEC. 35.

FINAL PROOF SURVEY UNDER



G-4644 G-4369
 Application No. G-4877 Permit No. G-4592
 IN NAME OF

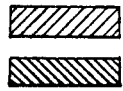

DARRELL PADBERG

Surveyed May 15 1974, by D. Norby