


G-4386

42251

T.3S., R.24E., W.M.

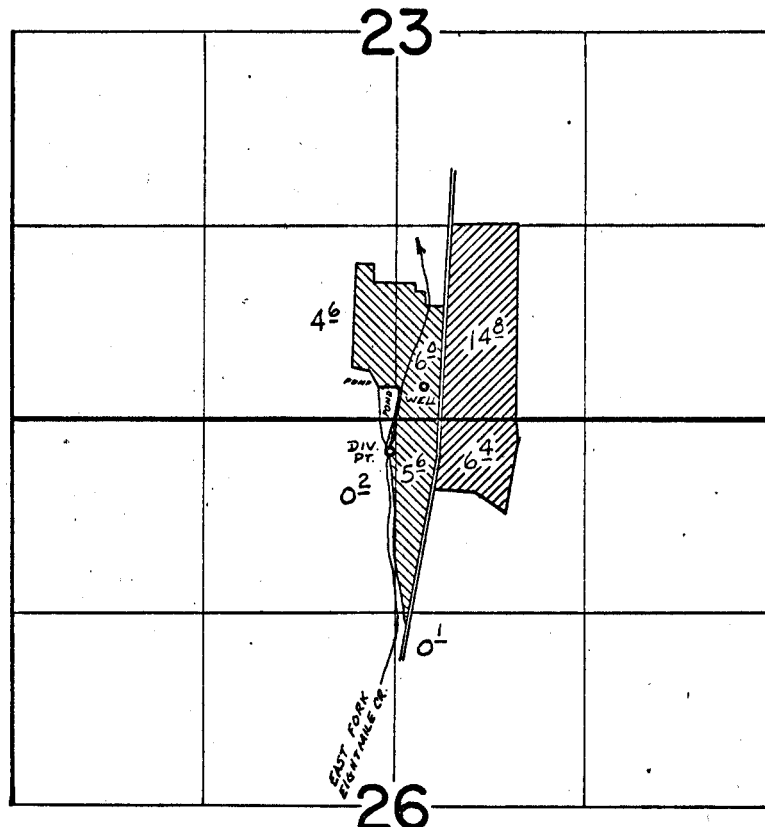

WELL LOCATED: 220' N & 1100' W FROM SE COR. SW $\frac{1}{4}$ SE $\frac{1}{4}$ SEC. 23.
 DIV. PT. LOCATED: 220' S & 1340' W FROM NE COR. NW $\frac{1}{4}$ NE $\frac{1}{4}$ SEC. 26.

 PRIMARY FROM CREEK & SUPPLEMENTAL FROM WELL
 PRIMARY FROM WELL

FINAL PROOF SURVEY UNDER

41905 31371
 Application No. G-4662 Permit No. G-4386
 IN NAME OF

LEONARD H. RILL

Surveyed May 8 1974, by D. J. Jorby