



T.2S., R.24E., W.M.

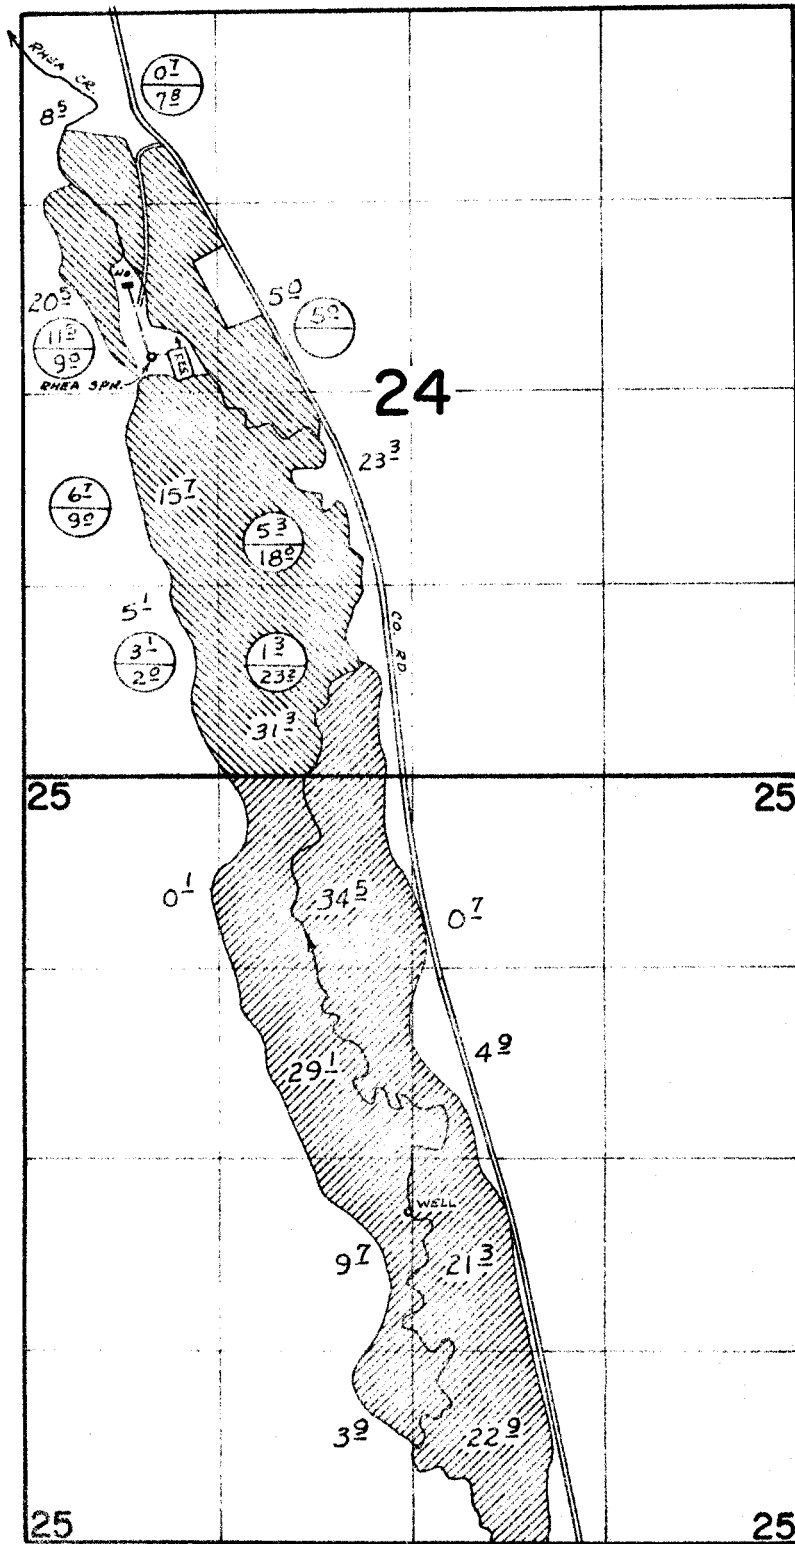

SPRING LOC. - 2350' S & 870' E FROM NW COR. SEC. 24.
WELL LOC. - 2280' N & 2620' E FROM SW COR. SEC. 25.
RES. LOC. - 2400' S & 1100' E FROM NW COR. SEC. 24

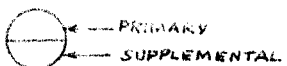

FROM RHEA SPRING AND RESERVOIR UNDER PERMIT 33814.

NOTE: ALL OTHER ACREAGES LISTED ARE FOR SUPPLEMENTAL FROM WELL UNDER PERMIT G-4482.

FINAL PROOF SURVEY UNDER


RHEA SPRING,
RESERVOIR & WELL

WELL ONLY


R-45281
45282

R-5342
33814

Application No G-4758 Permit No G-4482

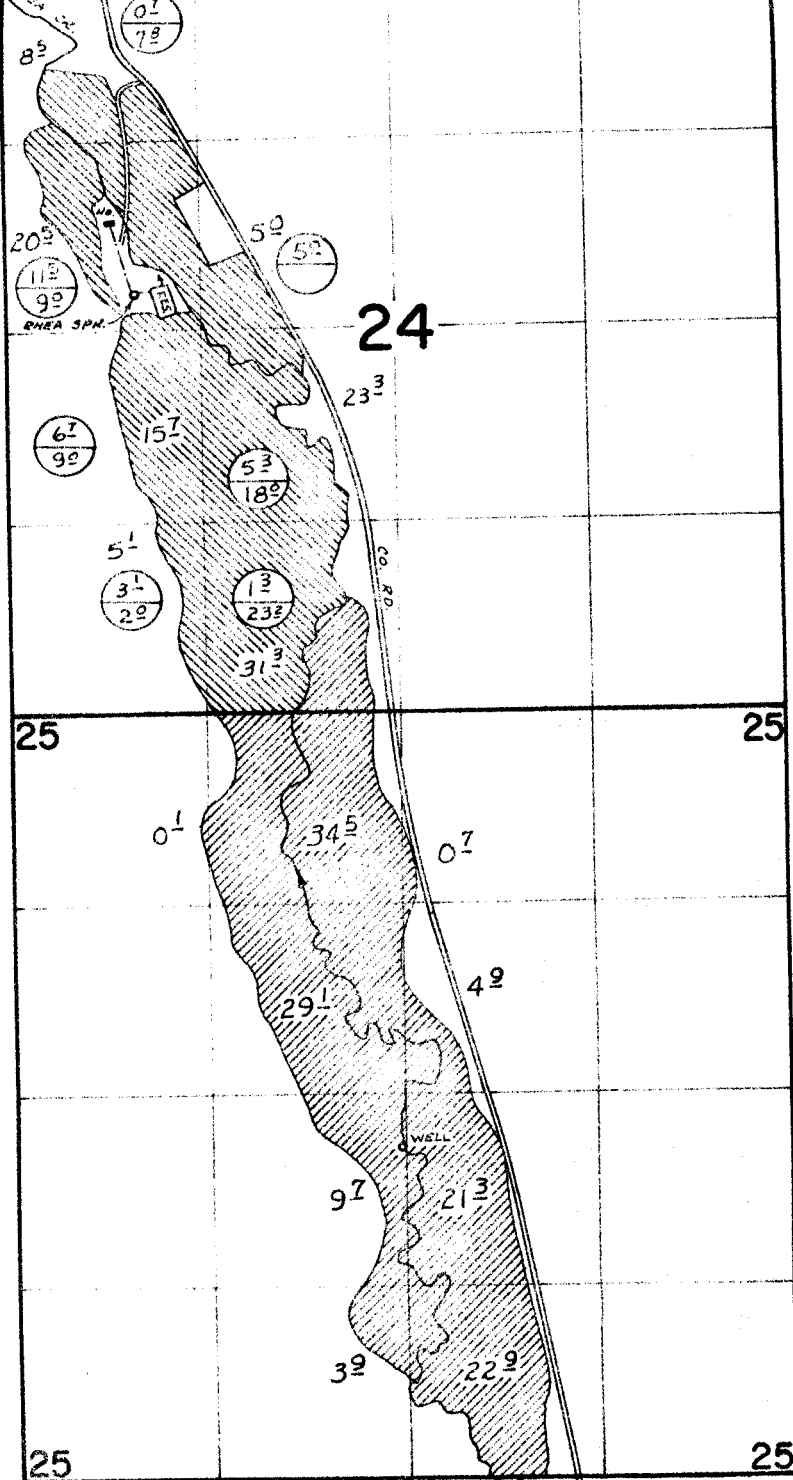

SPRING LOC. - 2380' S & 870' E FROM NW COR. SEC. 24.
 WELL LOC. - 2280' N & 2620' E FROM SW COR. SEC. 25.
 RES. LOC. - 2400' S & 1100' E FROM NW COR. SEC. 24

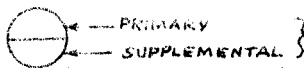

FROM RHEA SPRING AND RESERVOIR UNDER PERMIT 33814.

NOTE: ALL OTHER ACREAGES LISTED ARE FOR SUPPLEMENTAL FROM WELL UNDER PERMIT G-4482.

FINAL PROOF SURVEY UNDER



R-45281
 45282
 Application No. G-4758 Permit No. R-5342
 33814
G-4482
 IN NAME OF
SHIRLEY RUGG

Surveyed MAY 9 1974, by D. NORBY