


R-4826
42258

T.3S., R.24E., W.M.

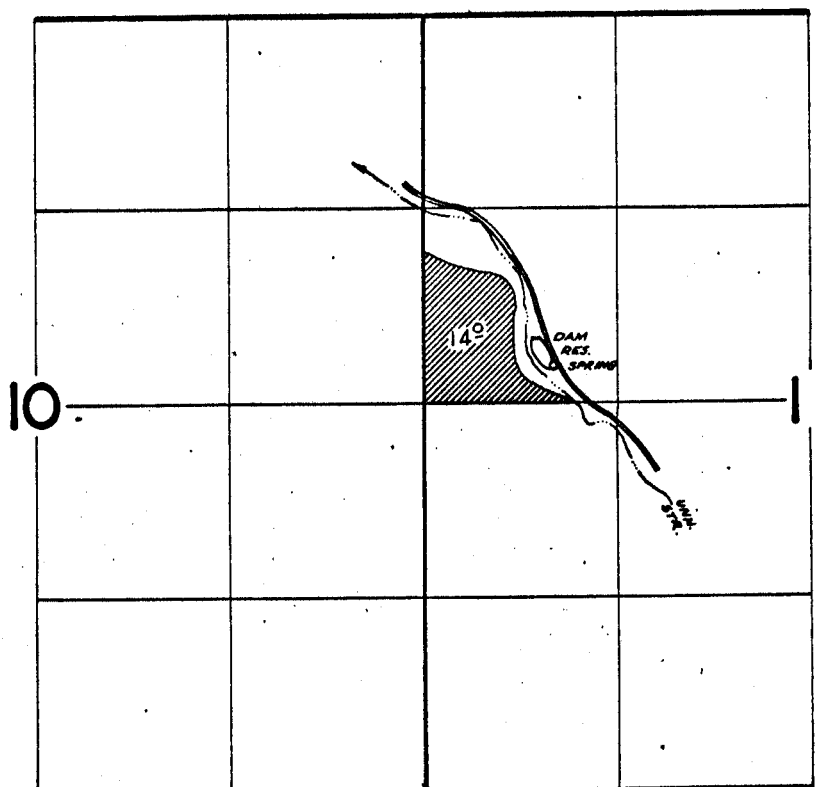

DAM LOCATED: 440' N & 760' E FROM W 1/2 COR SEC 11.

FINAL PROOF SURVEY
UNDER

R-42479 R-4826
Application No. 42480 Permit No. 31769
IN NAME OF

WILBUR WORDEN

Surveyed May 8 1974, by D. Dorby