


31770
42261

T.3S., R.24E., W.M.

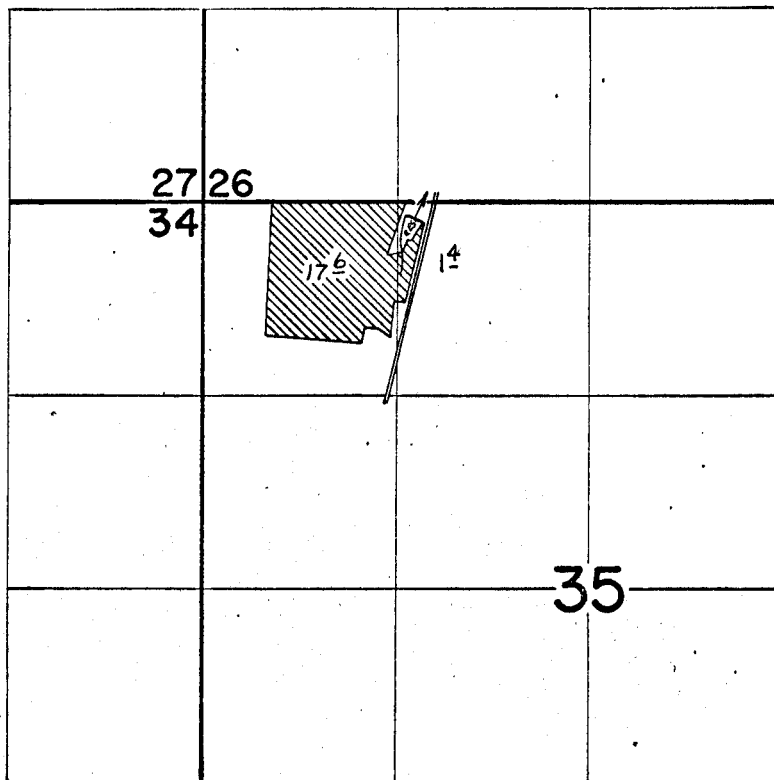

DAM LOCATED: 100' S & 1450' E FROM NW COR. SEC. 35.

FINAL PROOF SURVEY
UNDER

R-42481 R-4827
Application No. 42482 Permit No. 31770
IN NAME OF

MARJORIE WORDEN

Surveyed May 8 1974, by D. Dorby