


T.2S., R.24E., W.M.

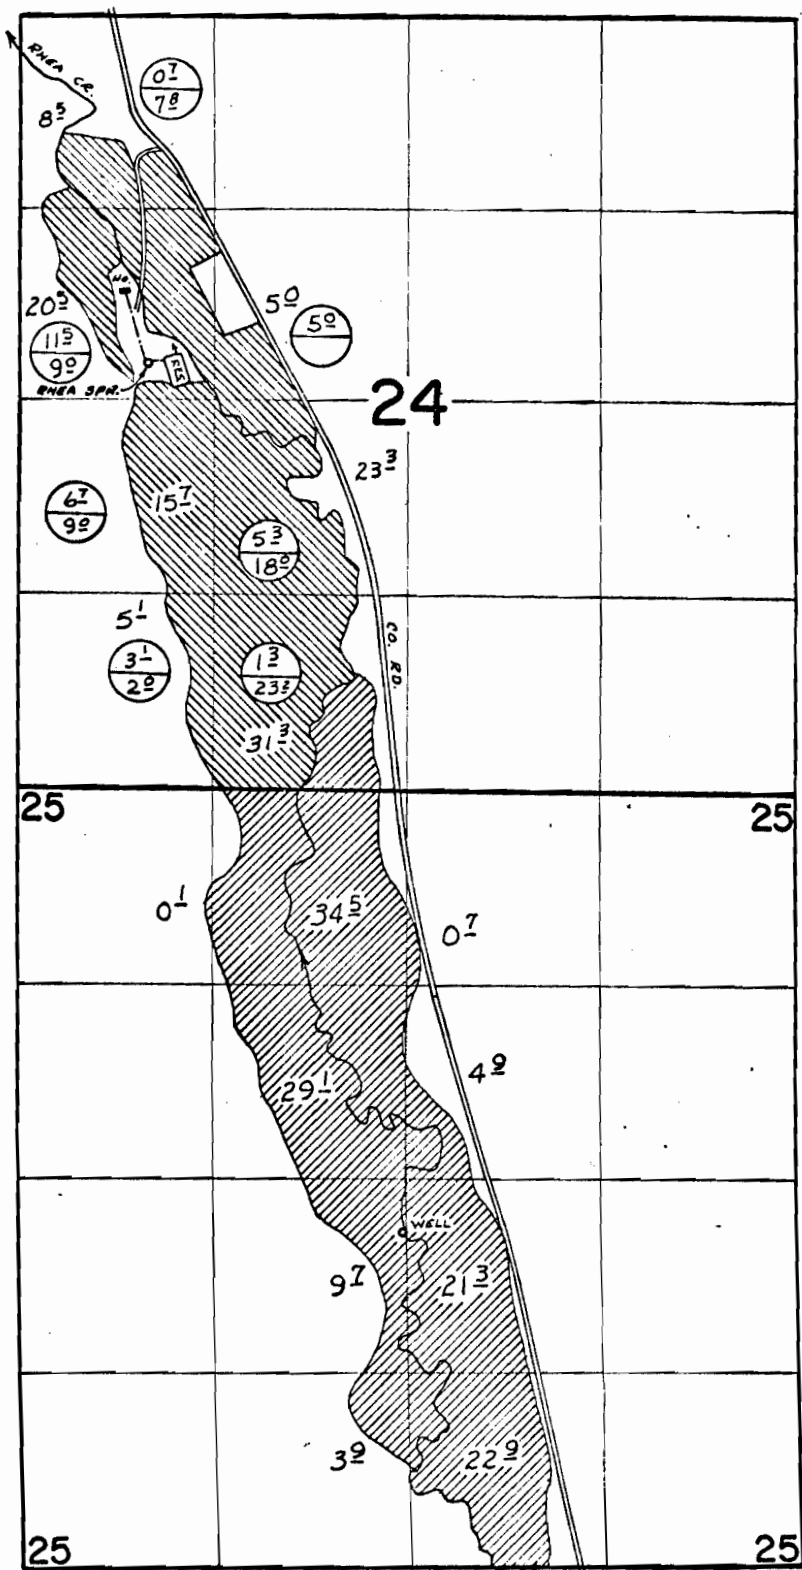

SPRING LOC. - 2350' S & 870' E FROM NW COR. SEC. 24.
WELL LOC. - 2280' N & 2620' E FROM SW COR. SEC. 25.
RES. LOC. - 2400' S & 1100' E FROM NW COR. SEC. 24

PRIMARY
SUPPLEMENTAL

FROM RHEA SPRING AND RESERVOIR UNDER PERMIT 33814.

NOTE: ALL OTHER ACREAGES LISTED ARE FOR SUPPLEMENTAL FROM WELL UNDER PERMIT G-4482.

FINAL PROOF SURVEY
UNDER

RHEA SPRING,
RESERVOIR & WELL
WELL ONLY

R-45281
45282
Application No. G-4758 Permit No. G-4482
IN NAME OF
SHIRLEY RUGG

R-5342
33814

Surveyed MAY 9 1974, by D. NORBY