


33814
42263

T.2S., R.24E., W.M.

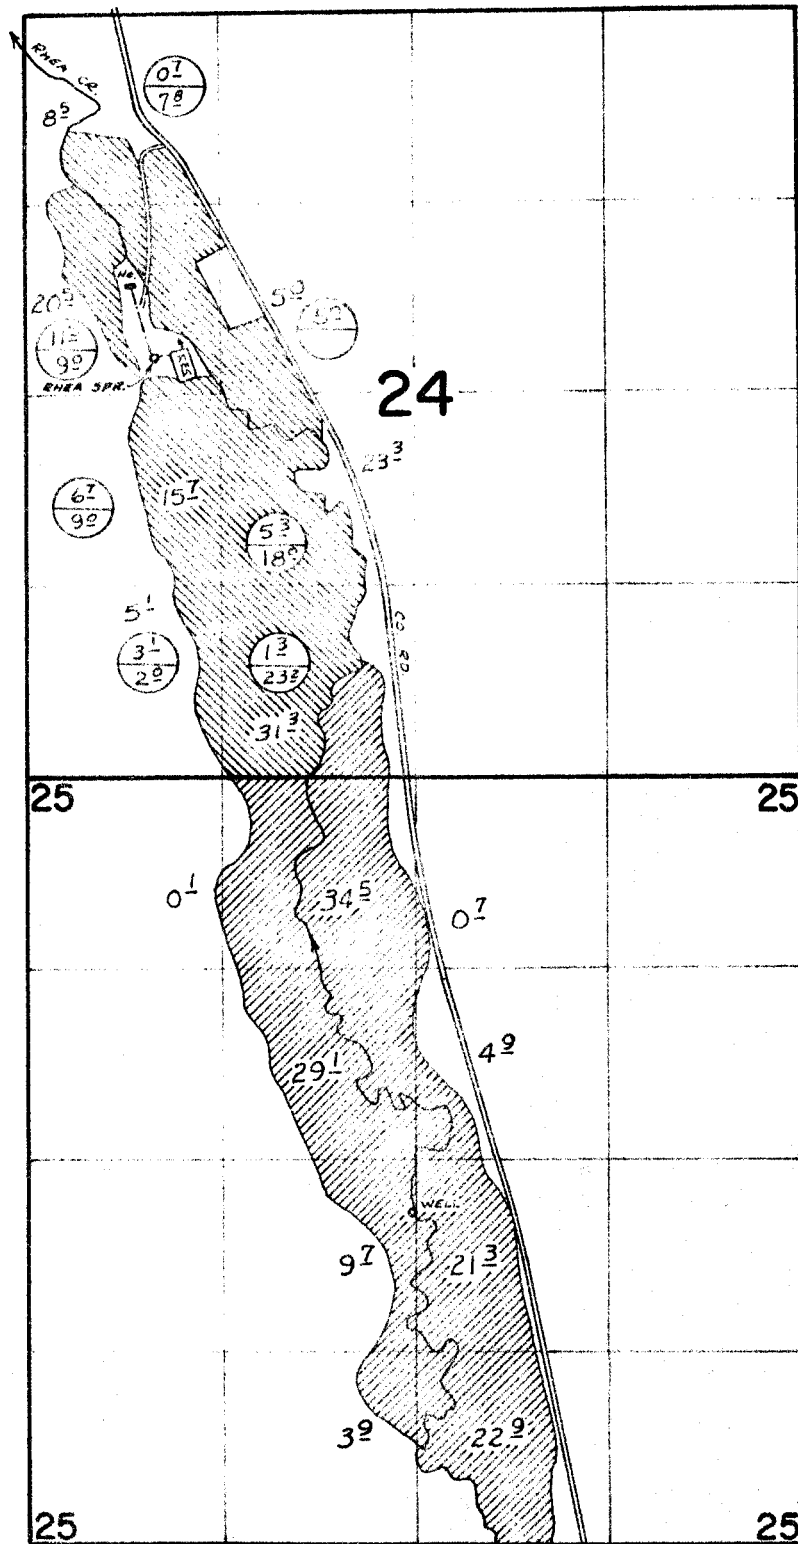


SPRING LOC. - 2350' S & 870' E FROM NW COR. SEC. 24.
WELL LOC. - 2200' N & 2620' E FROM SW COR. SEC. 25.
RES. LOC. - 2400' S & 1100' E FROM NW COR. SEC. 24


PRIMARY } FROM RHEA SPRING AND RESERVOIR UNDER PERMIT 33814.
SUPPLEMENTAL }

NOTE: ALL OTHER ACRESAGES LISTED ARE FOR SUPPLEMENTAL FROM WELL UNDER PERMIT G-4402.

FINAL PROOF SURVEY
UNDER

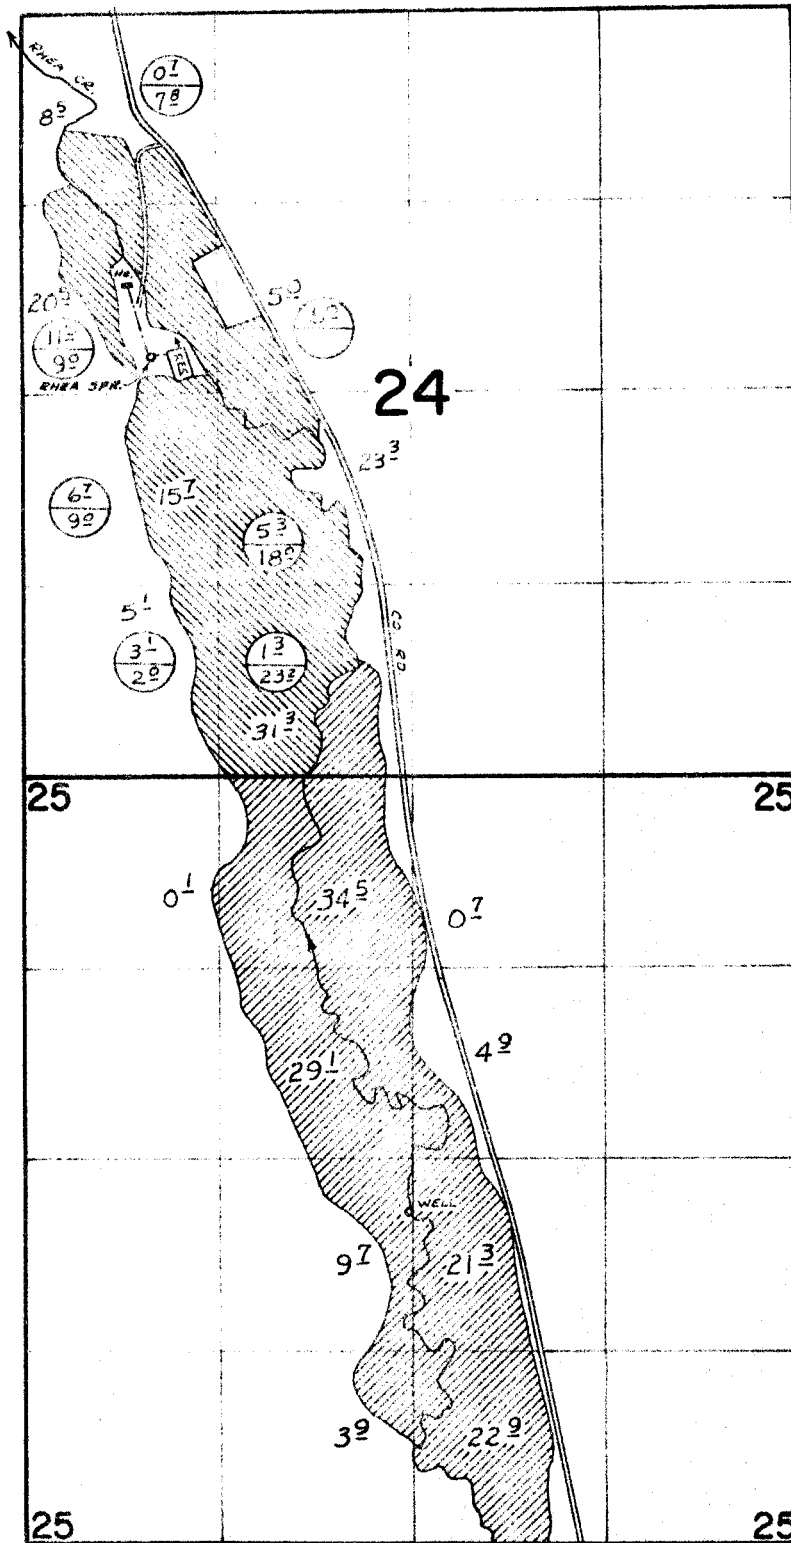

SPRING LOC. - 2350' S & 870' E FROM NW COR. SEC. 24.
 WELL LOC. - 2280' N & 2620' E FROM SW COR. SEC. 25.
 RES. LOC. - 2400' S & 1100' E FROM NW COR. SEC. 24

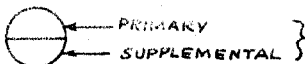

FROM RHEA SPRING AND RESERVOIR UNDER PERMIT 33814.

NOTE: ALL OTHER ACREAGES LISTED ARE FOR SUPPLEMENTAL FROM WELL UNDER PERMIT G-4482.

FINAL PROOF SURVEY UNDER



R-45281
 45282
 Application No. G-4758 Permit No. G-4482
 IN NAME OF
SHIRLEY RUGG

Surveyed MAY 9 1974, by D. NORBY