


T.9S.,R.5W.,WM.

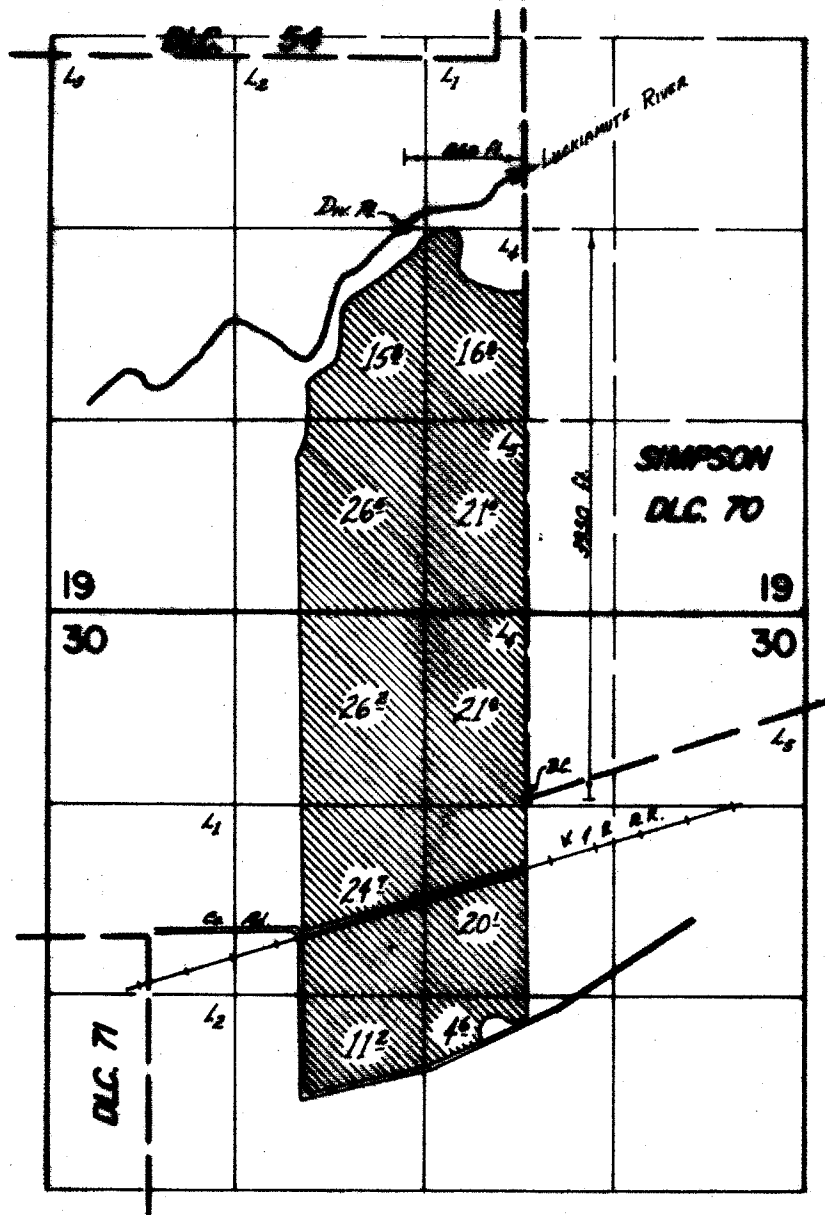

FINAL PROOF SURVEY
UNDER

Application No. 44930 Permit No. 33580
IN NAME OF

JOE J. MONTEZ

Surveyed Sept. 27, 1928, by J. Applegate