


T.9S.,R.5-6W.,W.M.

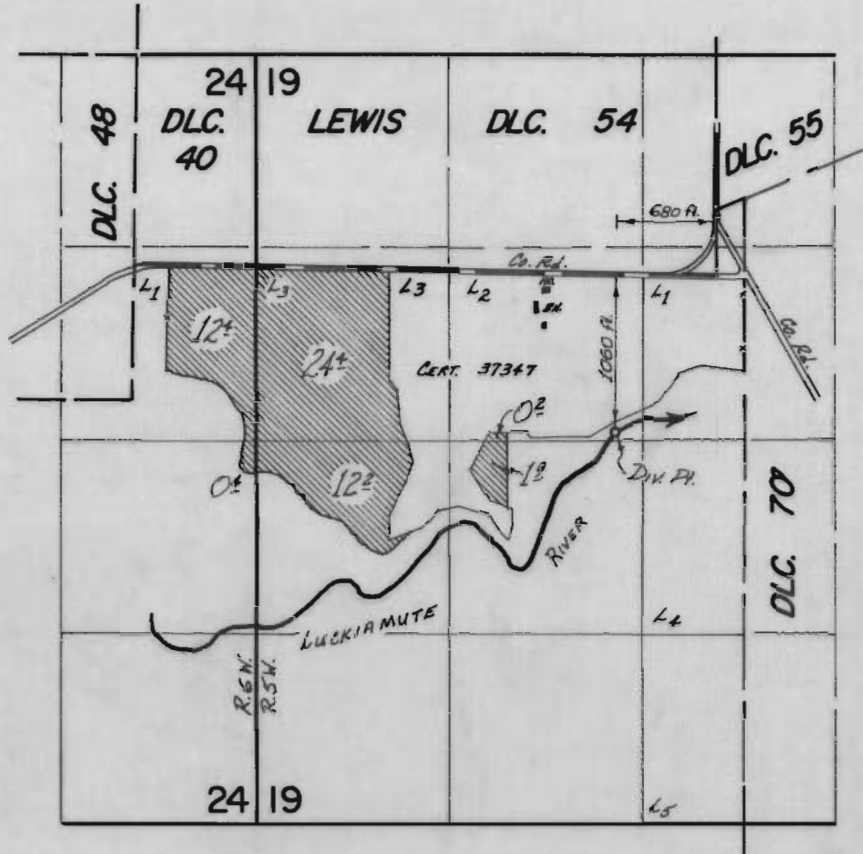

**FINAL PROOF SURVEY**  
UNDER

Application No. 48073 Permit No. 36059  
IN NAME OF

VERNON MEYER

Surveyed SEPT. 27 1973, by S. APPLIGATE